

LAND CORNER RECORDATION CERTIFICATE
Filing Requirement of Act 74, Mich. P.A. 1970

SECTION

For corners in

Form with fields for Bay (County), Located In: Hampton Twp., Corner Code #, and numbered sections 1-3 for Public Land Survey, Property Controlling, and Miscellaneous Property in Sec.

1999 DEC 28 P 1:00

Carolee Torres DeLoe
REGISTER OF DEEDS
BAY COUNTY, MICHIGAN

Register of Deeds Stamp & File Num

4. Lot No. , Recorded Plat
5. Private Claims

I, Roger P. Mahoney, in a field survey on 11-13, 1999 do hereby state that under requirements of P.A. 74, Michigan P.A. of 1970, the corner points mentioned in lines 1 and 2 above were in conformance with regulations and rules therefore as required in the current manual of survey instructions of the United States Department of the Interior, Bureau of Land Management or by a decree of a Court of Law and /or that the corner points mentioned in lines 3, 4 and 5 above were in conformance with the rules of the Michigan Board of Land Surveyors or by a Decree of a Court of Law; established, re-established, monumented, recovered, found as expressed below:

Grid table with columns A-L and rows 1-13, containing numbers 1-36.

NOTE: Not more than 2 corners, all in the same town and range, may be recorded on this certificate.

A. Description of original monument and accessories and/or subsequent restoration:


- M-6 Post set by J. Wampler, 1821. Found mon box - LCRC by McGinnis, 1977 - References incorrect mon box 4.5' West and 1.86' North. Found 3/8" iron in mon box - surveys by Edmands Engineering, 1975, 1985. Found mon box - survey by Edmands Engineering, 1975. Found mon box - survey by Ledy, 1983. Found iron in mon box - survey by Burgin, 1986, 1988. Found 3/8" iron in mon box - survey by Wade-Trim/Edmands, 1989, 1996. Found 1/2" iron bar from previous wit. - LCRC by Hughes, 1989. No object mentioned - surveys by Burgin, 1989, 1989. No object mentioned - survey by McGinnis, 1991.

B. Description of corner evidence found and/or method applied in restoring or reestablishing corner:

- M-6 Found 3/8" rod in mon box from witness on surveys by Edmands Engineering, Ledy, Burgin, Wade-Trim/Edmands and from LCRC by McGinnis and Hughes. Found mon box (empty) 7.4' West and 3.5' North. Accepted the 3/8" rod in mon box as the best available evidence of the position of the original corner.

C. Description of monument for corner and accessories established to perpetuate locating the position of the corner:

- M-6 Replaced 3/8" rod and mon box with 5/8" rod and Bay County remon cap stamped 41105 and new mon box. S.54°W. - 45.35' - found PK nail, North face P. pole. (rec'd 45.36 and 45.05'). N.56°E. - 63.14' - found PK nail Southeast face P. pole. (rec'd 63.22' and 62.88'). S.70°E. - 120.01' - set nail & Bay County tag in South face p. pole. S.25°E. - 47.07' - top center hydrant dated 1962. (rec'd 47.25', 47.08' and 47.2').

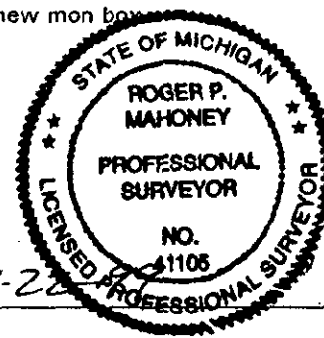

Signed by Roger P. Mahoney

Date 12-28

APPROVED LAND CORNER
P.A. 345 OF 1990 - Bay County
Date 6-24-99
Michael MacDonald P.S.
County Representative

Surveyor's Michigan License No. 41105

004 282