BAY COUNTY REMONUMENTATION

LAND CORNER RECORDATION CERTIFICATE

Filing Requirement of Act 74, Mich. P.A. 1970

For corners in Bay (County)

	Located In:	Corner Code #
1. Public Land Survey	T 14 N. R 5 E.	M-7
	T ____ R ____	
	T ____ R ____	
	T ____ R ____	
2. Property Controlling	S ____ T ____ R ____	
in Section	S ____ T ____ R ____	
3. Miscellaneous	S ____ T ____ R ____	
Property in Section	S ____ T ____ R ____	

RECORDED
DEC 22 12:35 PM '95
REGISTER OF DEEDS
BAY COUNTY, MICHIGAN

003 221

Register of Deeds Stamp & File Number

4. Lot No. _____, Recorded Plat _____
5. Private Claims _____

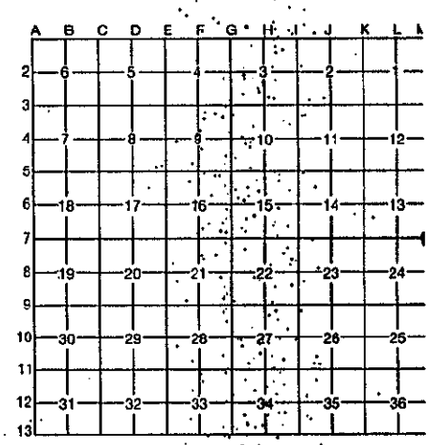

I, Ronald C. Prevost, in a field survey on June 22, 19 95, do hereby certify that under requirements of P.A. 74, Michigan P.A. of 1970, the corner points mentioned in lines 1 and 2 above were in conformance with regulations and rules therefore as required in the current manual of survey instructions of the United States Department of the Interior, Bureau of Land Management or by a decree of a Court of Law and/or that the corner points mentioned in lines 3, 4 and 5 above were in conformance with the rules of the Michigan Board of Professional Surveyors or by a Decree of a Court of Law; established, re-established, monumented, re-monumented, recovered, found as expressed below:

NOTE: Not more than 4 corners, all in the same town and range, may be recorded on this certificate.

A. Description of original monument and accessories and/or subsequent restoration:

M-7 Post by Wampler 1821
Ash 9" S. 9°W. 12 L
Ash 8" N.16 1/2°E. 14 L
LCRC L2 P443, T.14 N.-R.5 E., Mon. Box - McGinnis - 1975
LCRC L2 P616, T.14 N.-R.5 E., 5/8" Bar - Mon. Box - Hughes - 1989
LCRC as A-7, T.14 N.-R.6 E., L02 P345 - McGinnis - 1977
LCRC as A-7, T.14 N.-R.6 E., L002 P617 - 5/8" Bar Mon. Box - Hughes - 1989
Recorded Surveys L664 P147, L907 P330, L1242 P568, L881 P156, L928 P221, L687 P347,L1027 P116, L866 P497, L788 P404
Refer to Recorded Location.

B. Description of corner evidence found and/or method applied in restoring or reestablishing corner:

M-7 Found 5/8" Rod in Small Broken Mon. Box, Location Agrees with the Above
LCRC Recordings See Section C
Distance West 2710.41 (2710.44 R)(2709.88 R)(2709.65 R)
Distance South 2630.42 (2630.16 R)(2631.8 R)
Monument accepted as the best available evidence of the position of the original corner.

APPROVED LAND CORNER
P.A. 345 OF 1990 - Bay County
Date 22 June 95
MM
Michael MacDonald P.S.
County Representative

C. Description of monument for corner and accessories established to perpetuate locating the position of the corner:

M-7 Replaced 5/8" Rod with 5/8" Bar with 2 3/4" Bay Co. Brass Cap & Set New Mon. Box on 8-15-95

Ctr. Hyd.	S.45°W.	49.13	(49.18 R)	(49.2 R)
Nail & Ribbon S.W. Face P. & T. Pole	S.35°E.	45.53	(45.52 R)	
Spike in N.W. Face P. & T. Pole	N.49°E.	47.31	(46.7 R)	(47.33 R)
Ctr. M.H. Cover	S.70°W.	33.92		

STATE OF MICHIGAN
RONALD C. PREVOST
PROFESSIONAL SURVEYOR
NO. 24612
LICENSED PROFESSIONAL SURVEYOR

Signed by Ronald C. Prevost Date 12-8-95

Surveyor's Michigan License No. 24612

FORM APPROVED BY MICHIGAN STATE BOARD OF PROFESSIONAL SURVEYORS, JAN. 28, 1971
REVISED MAY 14, 1975
REVISED JAN., 1983