


**1996 BAY COUNTY REMONUMENTATION
LAND CORNER RECORDATION CERTIFICATE
Filing Requirement of Act 74, Mich. P.A. 1970**

003 330

For corners in

<u>Bay</u> (County)	Located In:	Corner Code #	
1. Public Land Survey	T <u>14N.</u> R <u>6 E.</u>	<u>G-12</u>	
	T <u>14N.</u> R <u>6 E.</u>	<u>G-13</u>	
	T _____ R _____	_____	_____
	T _____ R _____	_____	_____
2. Property Controlling in Section	S _____ T _____	R _____	_____
	S _____ T _____	R _____	_____
3. Miscellaneous Property in Sec.	S _____ T _____	R _____	_____
	S _____ T _____	R _____	_____

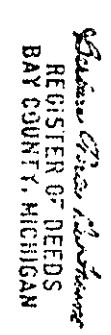

 REGISTER OF DEEDS
 BAY COUNTY, MICHIGAN
 Dec 27 2 42 PM '96
 RECORDED
 Register of Deeds Stamp & File Number

4. Lot No. _____, Recorded Plat _____
 5. Private Claims _____

I, Ronald C. Prevost, in a field survey on 7-9, 19 96 do hereby state that under requirements of P.A. 74, Michigan P.A. of 1970, the corner points mentioned in lines 1 and 2 above were in conformance with regulations and rules therefore as required in the current manual of survey instructions of the United States Department of the Interior, Bureau of Land Management or by a decree of a Court of Law and /or that the corner points mentioned in lines 3, 4 and 5 above were in conformance with the rules of the Michigan Board of Land Surveyors or by a Decree of a Court of Law; established, re-established, monumented, recovered, found as expressed below:

1	A	B	C	D	E	F	G	H	I	J	K	L
2	6			5			4		3		2	1
3												
4	7			8			9		10		11	12
5												
6	18			17			16		15		14	13
7												
8	19			20			21		22		23	24
9												
10	30			29			28		27		26	25
11												
12	31			32			33		34		35	36
13												

NOTE: Not more than 2 corners, all in the same town and range, may be recorded on this certificate.

A. Description of original monument and accessories and/or subsequent restoration:

- | | |
|--|--|
| <p>G-12 Post set by Risdon, 1834
 1/2" Rebar set by Cons.Pwr. Co. 1973.
 3/8" Rod found by Spicer Eng. 1992.</p> | <p>G-13 Post set by Wampler, 1821
 Cons. Pwr. Co. found mon box 1.5' deep, 1973.
 Ref. by Wade/Trim to Con. Pwr. Co. raised with 1/2 Re-bar.
 1/2" rod found by Spicer Eng. crew 1992.</p> |
|--|--|

B. Description of corner evidence found and/or method applied in restoring or reestablishing corner:

- | | |
|---|---|
| <p>G-12 Found 1/2" rod 7-9-96
 Witnesses from Act 132 L921 P608, agree.
 Witnesses from Spicer notes 1992, agree.
 Approved by Peer Group 8-8-96.</p> | <p>G-13 Found 1/2" rod in small mon box. 7-9-96.
 N.75°E. 111.0 nail & cap N. face U.P.(Cons. 1973 Ill.0)
 Agrees with 1992 Spicer notes.
 Approved by Peer Group 8-8-96.</p> |
|---|---|


C. Description of monument for corner and accessories established to perpetuate locating the position of the corner:

- | | |
|--|--|
| <p>G-12 Replaced 1/2" rod with 5/8" rod, Bay Co. Re-mon cap, & set
 Mon box 10-10-96.
 SE 65.32 to U.P. (nail & cap E. side)
 E. 2.0' to \pm N. & S. rd., in line with N. edge of ditch.
 N.E. 72.95 to top ctr. hyd.</p> | <p>G-13 Replaced 1/2" rod with 5/8" rod, Bay Co. Re-Mon cap in
 existing mon box. 10-3-96.
 N.75°E. 111.00 nail & cap N. face U.P.
 N.75°W. 95.55 Bay Co. Re-mon tag N. side T. pole.
 S.50°W. 70.27 Bay Co. Re-mon tag W. face P. pole.
 S.65°W. 100.67 Bay Co. Re-mon tag N.W. face P. pole.</p> |
|--|--|

APPROVED LAND CORNER
 P.A. 345 OF 1990 - Bay County
 Date 8 Aug 96
MJM
 Michael MacDonald P.S.
 County Representative

Signed by Ronald C. Prevost

Date 12-23-96

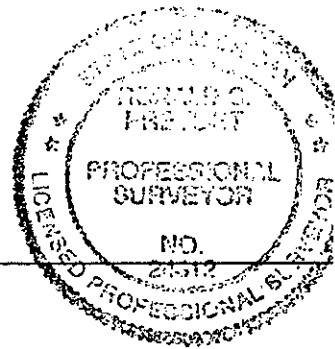

Surveyor's Michigan License No. 24612