

MAY 20 1997

1996 BAY COUNTY REMONUMENTATION  
LAND CORNER RECORDATION CERTIFICATE  
Filing Requirement of Act 74, Mich. P.A. 1970

003 327

For corners in

Bay (County)	Located In:	Corner Code #
1. Public Land Survey	T 14N R 6 E	I-12
	T R	
	T R	
	T R	
2. Property Controlling in Section	S T R	
	S T R	
3. Miscellaneous Property in Sec.	S T R	
	S T R	

REGISTER OF DEEDS  
 BAY COUNTY, MICHIGAN  
 Dec 27 2 33 PM '96  
 REGISTERED  
 Register of Deeds Stamp & File Number

4. Lot No. \_\_\_\_\_, Recorded Plat \_\_\_\_\_  
 5. Private Claims \_\_\_\_\_

I, Ronald C. Prevost, in a field survey on 7-17-96, 1996 do hereby state that under requirements of P.A. 74, Michigan P.A. of 1970, the corner points mentioned in lines 1 and 2 above were in conformance with regulations and rules therefor as required in the current manual of survey instructions of the United States Department of the Interior, Bureau of Land Management or by a decree of a Court of Law and/or that the corner points mentioned in lines 3, 4 and 5 above were in conformance with the rules of the Michigan Board of Land Surveyors or by a Decree of a Court of Law; established, re-established, monumented, recovered, found as expressed below:

	A	B	C	D	E	F	G	H	I	J	K	L
1												
2		6		5		4		3		2		1
3												
4		7		8		9		10		11		12
5												
6		18		17		16		15		14		13
7												
8		19		20		21		22		23		24
9												
10		30		29		28		27		26		25
11												
12		31		32		33		34		35		36
13												

NOTE: Not more than 2 corners, all in the same town and range, may be recorded on this certificate.

A. Description of original monument and accessories and/or subsequent restoration:

I-12 Post set by Risdon, 1834.  
 1/2" x 24" re-bar set by Cons. Pwr. Co., 1973, single proportion between I-11 & I-13.  
 LCRC L2 P218, P.K. 1976.  
 3/8" rod found by Spicer crew 1992.  
 Act 132, L800 P346, L858 P687, L972 P87, L1135, P276, L1315 P781.


B. Description of corner evidence found and/or method applied in restoring or reestablishing corner:

I-12 Found 3/8" rod 7-17-96.  
 S.62°W. 82.65 meter pole, L2 P218, (M82.65), same as C.P.Co. 1973  
 N.75°W. 72.70 P.P. (M72.70) same as C.P.Co. 1973.  
 Witnesses from Spicer notes, 1992, all agree.  
 Witnesses from Act 132 L858 P687, all agree.  
 Two witnesses from Act 132 L927 P87, agree.  
 Witnesses from Act 132 L1135 P276, all agree.  
 Approved by Peer Group 11-7-97.

C. Description of monument for corner and accessories established to perpetuate locating the position of the corner:

I-12 Replaced 3/8" rod with 5/8" rod, Bay Co. re-mon cap, set mon box. 12-19-96  
 S.60°E. 17.60 N.E. cor. pre-fab bridge.  
 S.30°E. 27.10 S.E. cor. pre-fab bridge.  
 S.40°E. 28.40 S.W. cor. pre-fab bridge.  
 S.70°W. 19.35 N.W. cor. pre-fab bridge.  
 S.62°W. 82.65 nail & cap N. face meter pole.  
 N.75°W. 72.20 P. pole nail & cap N. face.

APPROVED LAND CORNER  
 P.A. 345 OF 1990 - Bay County  
 Date 7 Nov 96  
MJM  
 Michael MacDonald P.S.  
 County Representative

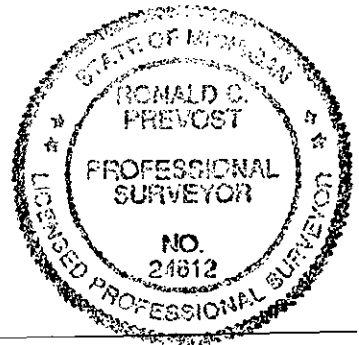

Signed by Ronald C. Prevost

Date 12-23-96

Surveyor's Michigan License No. 24612