

**1996 BAY COUNTY REMONUMENTATION
LAND CORNER RECORDATION CERTIFICATE
Filing Requirement of Act 74, Mich. P.A. 1970**

003 323

For corners in MAY 2 A 1997

<u>Bay</u> (County)	Located In:	Corner Code #
1. Public Land Survey	T <u>14N.</u> R <u>6E</u>	<u>M-11</u>
	T <u>14N.</u> R <u>6E.</u>	<u>M-12</u>
	T _____ R _____	_____
	T _____ R _____	_____
2. Property Controlling in Section	S _____ T _____ R _____	_____
	S _____ T _____ R _____	_____
3. Miscellaneous Property in Sec.	S _____ T _____ R _____	_____
	S _____ T _____ R _____	_____

REGISTER OF DEEDS
 BAY COUNTY, MICHIGAN
 DEC 27 2 33 PM '96
 RECORDED
 Register of Deeds Stamp & File Number

4. Lot No. _____, Recorded Plat _____
 5. Private Claims _____

I, Ronald C. Prevost, in a field survey on 8-1-M-11; 11-21-M-12, 19 96 do hereby state that under requirements of P.A. 74, Michigan P.A. of 1970, the corner points mentioned in lines 1 and 2 above were in conformance with regulations and rules therefore as required in the current manual of survey instructions of the United States Department of the Interior, Bureau of Land Management or by a decree of a Court of Law and/or that the corner points mentioned in lines 3, 4 and 5 above were in conformance with the rules of the Michigan Board of Land Surveyors or by a Decree of a Court of Law; established, re-established, monumented, recovered, found as expressed below:

A	B	C	D	E	F	G	H	I	J	K	L
1											
2	6		5		4		3		2		1
3											
4	7		8		9		10		11		12
5											
6	18		17		16		15		14		13
7											
8	19		20		21		22		23		24
9											
10	30		29		28		27		26		25
11											
12	31		32		33		34		35		36
13											

NOTE: Not more than 2 corners, all in the same town and range, may be recorded on this certificate.

A. Description of original monument and accessories and/or subsequent restoration:

M-11 Post set by Wampler, 1821 Cons. Pwr. Co. found mon box in E. road, no date. LCRC L2 P631, 5/8" iron in mon box 1989.	M-12 Post set by Wampler, 1821 Cons. Pwr. Co. used single proportion location between M-11 & M-13 with 1/2 mile distances being 2638.70 each way. No point was set.
---	--

B. Description of corner evidence found and/or method applied in restoring or reestablishing corner:


M-11 Found 5/8" iron in mon box 8-1-96. LCRC L2 P631. N.43°W. 103.61 M.D.O.T. nail in P. pole (M 103.61) N.14°W. 81.66 M.D.O.T. nail in P. pole (M 81.66) S.14°W. 30.00 face corner fence post (M 30.35) Approved by Peer Group 11-7-96.	M-12 No evidence of corner found, set point on line between M-11 & M-13. Held distance of 2638.70 from M-11 to M-12 as per Con. Pwr. Co. The distance from M-12 to M-13 was 2676.02 feet M-13 location being different than Consumers location. Approved by Peer Group 11-21-96.
--	--

C. Description of monument for corner and accessories established to perpetuate locating the position of the corner:

M-11 Replaced 5/8" iron with 5/8" bar, Bay Co. Re-mon cap in existing mon box (11-21-96). N.43°W. 103.61 M.D.O.T. ref. nail in P. pole. N.14°W. 81.66 M.D.O.T. ref. nail in P. pole. S.14°W. 30.35 face corner fence post. West 71.54 to ctr. corner fence post.	M-12 Placed 5/8" Re-rod in concrete with Bay County Re-mon cap on top East and West dike. (11-21-96). S.88°W. 76.10 set Bay Co. wit. tag in E. side 72" Willow. S.40°W. 36.84 set Bay Co. wit. tag in NE. side 6" Willow. N.15°W. 30.0 set Bay Co. wit. tag in S. side 8" Willow. S.45°E. 26.40 set Bay Co. wit. tag in W. side 6" Willow.
--	--

APPROVED LAND CORNER
 P.A. 345 OF 1990 - Bay County
 Date 11 Nov 96
MJM
 Michael MacDonald P.S.
 County Representative

APPROVED LAND CORNER
 P.A. 345 OF 1990 - Bay County
 Date 11 Nov 96
MJM
 Michael MacDonald P.S.
 County Representative

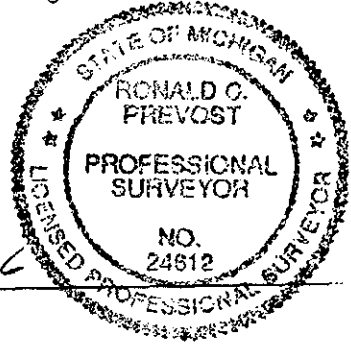

Signed by Ronald C. Prevost

Date 12-23-96

Surveyor's Michigan License No. 24612