

**BAY COUNTY REMONUMENTATION 1998
LAND CORNER RECORDATION CERTIFICATE
Filing Requirement of Act 74, Mich. P.A. 1970**

For corners in

BAY Located in: Corner Code #
(County)

1. Public Land Survey T 15N R 3E F-1
T _____ R _____

2. Property Controlling S _____ T _____ R _____

3. Miscellaneous S _____ T _____ R _____
Property in Sec. S _____ T _____ R _____

Michael MacDonal
 REGISTER OF DEEDS
 BAY COUNTY, MICHIGAN

1999 JAN -5 A 9:05

RECORDED

Register of Deeds Stamp & File Number

4. Lot No. _____, Recorded Plat _____
5. Private Claims _____

I, BRIAN D FERGUSON, in a field survey on OCTOBER, 19 98 do hereby state that under requirements of P.A. 74, Michigan P.A. of 1970, the corner points mentioned in lines 1 and 2 above were in conformance with regulations and rules therefore as required in the current manual of survey instructions of the United States Department of the Interior, Bureau of Land Management or by a decree of a Court of Law and/or that the corner points mentioned in lines 3, 4 and 5 above were in conformance with the rules of the Michigan Board of Land Surveyors or by a Decree of a Court of Law; established, re-established, monumented, recovered, found as expressed below:

NOTE: Not more than 2 corners, all in the same town and range, may be recorded on this certificate.

1	A	B	C	D	E	F	G	H	I	J	K	L	M
2		6		5		4		3		2		1	
3													
4		7		8		9		10		11		12	
5													
6		18		17		16		15		14		13	
7													
8		19		20		21		22		23		24	
9													
10		30		29		28		27		26		25	
11													
12		31		32		33		34		35		36	
13													

A. Description of original monument and accessories and/or subsequent restoration:

CORNER NOT SET DURING ORIGINAL TOWNSHIP SURVEY
 SURVEY BY BURGIN IN 1993, REC L. 1308, PG. 402
 SURVEY BY SCHAFER IN 1979, REC L. 880, PG. 390
 SURVEY BY CIOSEK IN 1982, REC L. 921, PG. 578
 SURVEY BY WADE-TRIM IN 1997, REC L. 1477, PG. 312

SURVEY &
REMONUMENTATION

MAR 17 1999

SECTION

B. Description of corner evidence found and/or method applied in restoring or reestablishing corner:


FOUND 3/8" IRON ROD AT SPLIT BETWEEN E-1 & G-1, 0.44' SOUTH. MOVE TO STANDARD LINE
 AGREES WITH LOCATION FROM RECORDED SURVEYS

ACCEPTED AS THE BEST AVAILABLE EVIDENCE OF THE LOCATION OF THE ORIGINAL CORNER

C. Description of monument for corner and accessories established to perpetuate locating the position of the corner:

SET 5/8" RE-BAR W / BAY COUNTY REMON. BRASS CAP & NO. 26454 IN MONUMENT BOX
 N10°E 37.93' NAIL & PLASTIC WITNESS CAP S FCE 10" GATE POST
 N25°W 43.20' NAIL & SHINNER S FCE 10" GATE POST
 S90°W 6.00' 1" IRON PIN
 S50°W 54.98' NAIL & SHINNER E FCE 10" W. PINE
 S05°W 33.25' "T" IRON W/CAP 29140

APPROVED LAND CORNER
 P.A. 345 OF 1990 - Bay County
 Date 22 Oct 98
MJM
 Michael MacDonald P.S.
 County Representative

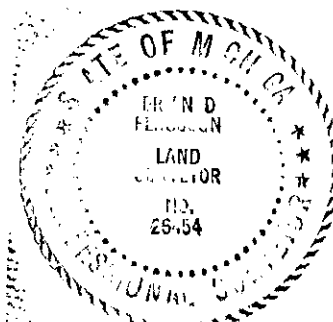

Signed by Brian D Ferguson
 Surveyor's Michigan License No. 26454

Date December 23, 1998