


**SURVEY &  
REMONUMENTATION BAY COUNTY REMONUMENTATION 1997  
LAND CORNER RECORDATION CERTIFICATE  
APR 23 1998 Filing Requirement of Act 74, Mich. P.A. 1970**

For corners in SECTION \_\_\_\_\_

Bay (County)	Located In:	Corner Code #
1. Public Land Survey	T 15N R 3E	I-1
	T _____ R _____	_____
	T _____ R _____	_____
	T _____ R _____	_____
2. Property Controlling in Section	S _____ T _____ R _____	_____
	S _____ T _____ R _____	_____
3. Miscellaneous Property in Sec.	S _____ T _____ R _____	_____
	S _____ T _____ R _____	_____

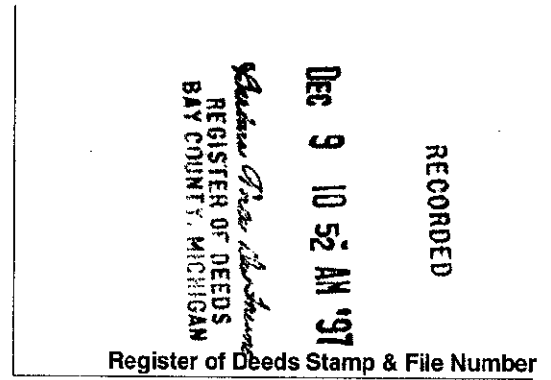

4. Lot No. \_\_\_\_\_, Recorded Plat \_\_\_\_\_  
5. Private Claims \_\_\_\_\_

I, Ronald C. Prevost, in a field survey on October, 1997 do hereby state that under requirements of P.A. 74, Michigan P.A. of 1970, the corner points mentioned in lines 1 and 2 above were in conformance with regulations and rules therefore as required in the current manual of survey instructions of the United States Department of the Interior, Bureau of Land Management or by a decree of a Court of Law and for that the corner points mentioned in lines 3, 4 and 5 above were in conformance with the rules of the Michigan Board of Land Surveyors or by a Decree of a Court of Law; established, re-established, monumented, recovered, found as expressed below:

**NOTE: Not more than 2 corners, all in the same town and range, may be recorded on this certificate.**

	A	B	C	D	E	F	G	H	I	J	K	L	M
1													
2	6			5		4		3		2		1	
3													
4	7			8		9		10		11		12	
5													
6	18			17		16		15		14		13	
7													
8	19			20		21		22		23		24	
9													
10	30			29		28		27		26		25	
11													
12	31			32		33		34		35		36	
13													

A. Description of original monument and accessories and/or subsequent restoration:


- I-1 Post set by D.S. Hervey Parke, 1831, closing corner, 28 Lks West.  
Co. Surveyor Info 1909  
LCRC L1 P271 Goss, 1972, mon box.  
LCRC L1 P503, Whittier, 1972 iron in mon box.  
LCRC L3 P6, Ciosek, 1992 1/2" re-bar in mon box 0.23 N of Twp. line.  
Act 132 L866 P507, Goss, 1979 mon box.  
Act 132 L962 P625, Ledy, 1983 mon box.  
Act 132 L968 P433, Ciosek, 1984 mon box.

B. Description of corner evidence found and/or method applied in restoring or reestablishing corner:

- I-1 Found 1/2" rod in mon box, also found point on S. rim of box.  
Recovered one wit from L1 P271 that agrees.  
Recovered three wit's from L3 P6 that agrees.  
Note: Peer group decided to approve the point on rim of mon box 0.25 S of 1/2" rod in mon box because of it being on Twp. line.  
Peer group approved \_\_\_\_\_  
Monument accepted as best available evidence of the position of the original corner.

C. Description of monument for corner and accessories established to perpetuate locating the position of the corner:

- I-1 Replaced mon box and set 5/8" re-rod, Bay Co. re-mon cap in place of point on S. rim of mon box which was on Twp. line and 0.25 South of 1/2" rod. 11-4-97.  
N.45°W. 43.25 P.K. in U.P.  
N.50°E. 101.87 P.K. in U.P.  
S.45°E. 93.80 P.K. in U.P.  
S.35°W. 72.35 nail & tag ctr. 16" Spruce.  
E. 18.48 re-mon corner I-13, T.16 N.-R.3 E.

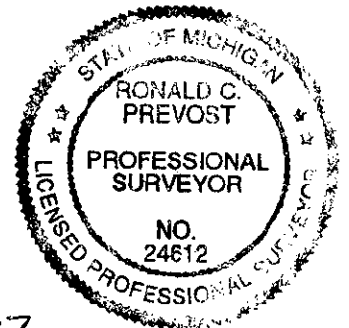

Signed by Ronald C. Prevost  
Ronald C. Prevost

Date 11-12-97

Surveyor's Michigan License No. 24612

APPROVED LAND CORNER  
P.A. 345 OF 1990 - Bay County  
Date 27 Oct 97  
MJM  
Michael MacDonald P.S.  
County Representative

FORM APPROVED BY MICHIGAN STATE BOARD OF PROFESSIONAL SURVEYORS, JAN. 28, 1971  
REVISED, MAY 14, 1975  
REVISED JAN., 1983  
REVISED OCT., 1995

004

38