

**SURVEY & REMONUMENTATION**

**BAY COUNTY REMONUMENTATION 1997**


**APR 23 1998**

**LAND CORNER RECORDATION CERTIFICATE**

**Filing Requirement of Act 74, Mich. P.A. 1970**

For corners in **SECTION**

<u>Bay</u> (County)	Located In:	Corner Code #
1. Public Land Survey	T <u>15N</u> R <u>3E</u>	<u>J-1</u>
	T _____ R _____	_____
	T _____ R _____	_____
	T _____ R _____	_____
2. Property Controlling in Section	S _____ T _____ R _____	_____
	S _____ T _____ R _____	_____
3. Miscellaneous Property in Sec.	S _____ T _____ R _____	_____
	S _____ T _____ R _____	_____

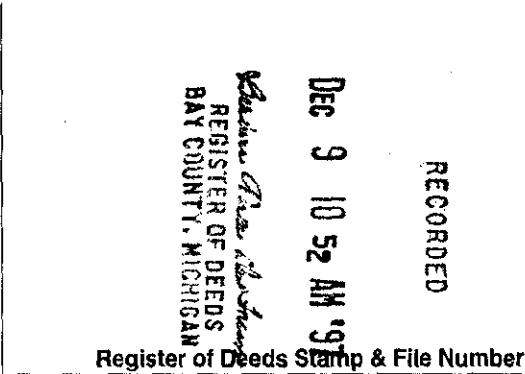

4. Lot No. \_\_\_\_\_, Recorded Plat \_\_\_\_\_  
5. Private Claims \_\_\_\_\_

I, Ronald C. Prevost, in a field survey on October, 1997 do hereby state that under requirements of P.A. 74, Michigan P.A. of 1970, the corner points mentioned in lines 1 and 2 above were in conformance with regulations and rules therefore as required in the current manual of survey instructions of the United States Department of the Interior, Bureau of Land Management or by a decree of a Court of Law and /or that the corner points mentioned in lines 3, 4 and 5 above were in conformance with the rules of the Michigan Board of Land Surveyors or by a Decree of a Court of Law; established, re-established, monumented, recovered, found as expressed below:

**NOTE: Not more than 2 corners, all in the same town and range, may be recorded on this certificate.**

	A	B	C	D	E	F	G	H	I	J	K	L	M
1													
2		6		5		4		3		2		1	
3													
4		7		8		9		10		11		12	
5													
6		18		17		16		15		14		13	
7													
8		19		20		21		22		23		24	
9													
10		30		29		28		27		26		25	
11													
12		31		32		33		34		35		36	
13													

A. Description of original monument and accessories and/or subsequent restoration:

J-1 Corner not set in original Gov't survey, 1831 Co. Surveyor info 1909.  
LCRC L1 P269, Goss, 1972, mon box.  
Act 132 L784 P143, McGinnis, 1976 fnd.  
Act 132 L784 P144, McGinnis, 1976 fnd.  
Act 132 L968 P433, Closek, 1984 mon box.

B. Description of corner evidence found and/or method applied in restoring or reestablishing corner:

J-1 Found 3/4" pipe in mon box.  
Recovered two wit's L784 P143, that check.  
Recovered two wit's L784 P144 that check.  
Recovered two wit's L968 P433 that check.  
Agrees ± with W/T EDS previous measurement to K-1, (2647.89M) (2647.72 & 2648.12 rec).

C. Description of monument for corner and accessories established to perpetuate locating the position of the corner:

J-1 Replaced 3/4" pipe with 5/8" re-rod, Bay Co. re-mon cap in existing mon box 11-4-97.  
E. 2609 re-mon corner J-13, T.16 N.-R.3 E. (26.00 rec)  
N.02°E. 71.20 nail & tag E side P pole.  
S.70°E. 84.70 nail & tag W side 30" Maple (84.43 face rec)  
South 31.52 ctr 4" steel gate post.



Signed by Ronald C. Prevost  
Ronald C. Prevost

Date 11-12-97

Surveyor's Michigan License No. 24612

APPROVED LAND CORNER  
P.A. 345 OF 1990 - Bay County  
Date 23 Oct 97  
MJM  
Michael MacDonald P.S.  
County Representative



004

39