

SURVEY & REMONUMENTATION

APR 23 1998

BAY COUNTY REMONUMENTATION

LAND CORNER RECORDATION CERTIFICATE
Filing Requirement of Act 74, Mich. P.A. 1970

SECTION
For corners in

BAY
(County)

Located in: KAWKAWLIN TWP Corner Code #

- 1. Public Land Survey T 15N R 4E B-13
- 2. Property Controlling S T R
- 3. Miscellaneous S T R
- Property in Sec. S T R

Dec 30 3 51 PM '97
REGISTER OF DEEDS
BAY COUNTY, MICHIGAN

RECORDED

Register of Deeds Stamp & File Number

- 4. Lot No. _____ Recorded Plat _____
- 5. Private Claims _____

I, BRIAN D FERGUSON, in a field survey on MAY 5, 19 97 do hereby state that under requirements of P.A. 74, Michigan P.A. of 1970, the corner points mentioned in lines 1 and 2 above were in conformance with regulations and rules therefore as required in the current manual of survey instructions of the United States Department of the Interior, Bureau of Land Management or by a decree of a Court of Law and/or that the corner points mentioned in lines 3, 4 and 5 above were in conformance with the rules of the Michigan Board of Land Surveyors or by a Decree of a Court of Law; established, re-established, monumented, recovered, found as expressed below:

A	B	C	D	E	F	G	H	I	J	K	L	M
1												
2	6		5		4		3		2		1	
3												
4	7		8		9		10		11		12	
5												
6	18		17		16		15		14		13	
7												
8	19		20		21		22		23		24	
9												
10	30		29		28		27		26		25	
11												
12	31		32		33		34		35		36	
13												

NOTE: Not more than 2 corners, all in the same town and range, may be recorded on this certificate.

A. Description of original monument and accessories and/or subsequent restoration:

B-13 WOOD POST SET BY JOHN MULLETT IN 1839 - 40
NO EVIDENCE OF ORIGINAL CORNER REMAINS
NO LCRC'S RECORDED FOR THIS CORNER


B. Description of corner evidence found and/or method applied in restoring or reestablishing corner:

B-13 FOUND "T" IRON AT LOCATION REFERENCED BY SURVEYS RECORDED IN L 1014 P 425; L 673 P 273; L 1103 P 627

THIS POSITION IS ACCEPTED AS THE BEST AVAILABLE EVIDENCE OF THE POSITION OF THE ORIGINAL CORNER

C. Description of monument for corner and accessories established to perpetuate locating the position of the corner:

B-13 SET 5/8" ROD W/3" BRASS BAY COUNTY REMONUMENTATION DISK IN MONUMENT BOX
N05W 23.35' TOP CTR M.B.T. RISER
N45E 123.05' PK NAIL NW FCE PWR POLE
N20E 57.94' S FCE 12" PINE TREE
SOUTH 4.10' SOUTH EDGE OF PAVEMENT

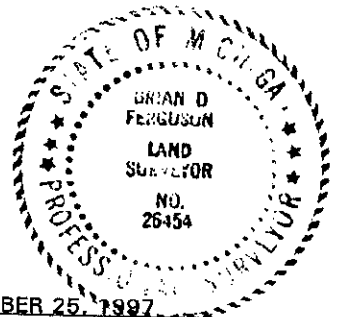

Signed by Brian D Ferguson
Surveyor's Michigan License No. 26454

Date NOVEMBER 25, 1997

APPROVED LAND CORNER
P.A. 345 OF 1990 - Bay County
Date 3 Oct 97
HJM
Michael MacDonald P.S.