

SURVEY & REMONUMENTATION

APR 23 1998

BAY COUNTY REMONUMENTATION

SECTION

LAND CORNER RECORDATION CERTIFICATE

Filing Requirement of Act 74, Mich. P.A. 1970

For corners in

BAY Located in: KAWKAWLIN TWP Corner Code #
 (County)

1. Public Land Survey T 15N R 4E C-11
 T _____ R _____

2. Property Controlling S _____ T _____ R _____
 in Section S _____ T _____ R _____

3. Miscellaneous S _____ T _____ R _____
 Property in Sec. S _____ T _____ R _____

REGISTER OF DEEDS
 BAY COUNTY, MICHIGAN
 Dec 30 3 51 PM '97
 RECORDED
 Register of Deeds Stamp & File Number

4. Lot No. _____ Recorded Plat _____
 5. Private Claims _____

I, BRIAN D FERGUSON, in a field survey on MAY 5, 1997 do hereby state that under requirements of P.A. 74, Michigan P.A. of 1970, the corner points mentioned in lines 1 and 2 above were in conformance with regulations and rules therefore as required in the current manual of survey instructions of the United States Department of the Interior, Bureau of Land Management or by a decree of a Court of Law and/or that the corner points mentioned in lines 3, 4 and 5 above were in conformance with the rules of the Michigan Board of Land Surveyors or by a Decree of a Court of Law; established, re-established, monumented, recovered, found as expressed below:

NOTE: Not more than 2 corners, all in the same town and range, may be recorded on this certificate.

	A	B	C	D	E	F	G	H	I	J	K	L	M
1													
2	0		5		4		3		2		1		
3													
4	7		8		9		10		11		12		
5													
6	18		17		18		15		14		13		
7													
8	19		20		21		22		23		24		
9													
10	30		29		28		27		26		25		
11													
12	31		32		33		34		35		36		
13													

A. Description of original monument and accessories and/or subsequent restoration:

C-11 WOOD POST SET BY JOHN MULLETT IN 1839 - 40
 NO EVIDENCE OF ORIGINAL CORNER REMAINS
 LCRC RECORDED IN L 002 P 633

B. Description of corner evidence found and/or method applied in restoring or reestablishing corner:


C-11 FOUND 3/4" PIPE W/ SPIKE IN MONUMENT BOX
 AGREES WITH LOCATION REFERENCED BY SURVEYS RECORDED IN L 1343 P 521; L 737 P 313; L1225 P 409;
 L 1354 P 571

THIS POSITION IS ACCEPTED AS THE BEST AVAILABLE EVIDENCE OF THE POSITION OF THE ORIGINAL CORNER

C. Description of monument for corner and accessories established to perpetuate locating the position of the corner:

C-11 SET 5/8" ROD W/3" BRASS BAY COUNTY REMONUMENTATION DISK IN MONUMENT BOX

N15E	44.90'	NAIL & TAG IN PWR POLE
N50W	57.16'	PK IN SW FCE PWR POLE
S45W	72.70'	NE COR BLOCK PORCH
S25E	51.05'	NW FCE GUY POLE

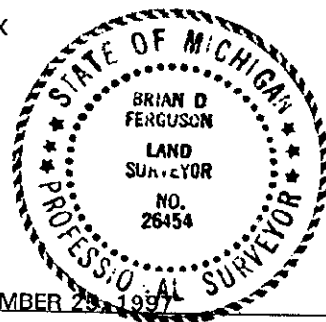

Signed by Brian D Ferguson Date NOVEMBER 23, 1997
 Surveyor's Michigan License No. 26454

APPROVED LAND CORNER
 P.A. 345 OF 1990 - Bay County
 Date 21 Aug 97
MJM
 Michael MacDonald P.S.
 County Representative