

SURVEY & REMONUMENTATION

APR 23 1998

BAY COUNTY REMONUMENTATION

LAND CORNER RECORDATION CERTIFICATE
Filing Requirement of Act 74, Mich. P.A. 1970

SECTION

For corners in

BAY Located in: KAWKAWLIN TWP Corner Code #
(County)

1. Public Land Survey T 15N R 4E D-13
T _____ R _____

2. Property Controlling S _____ T _____ R _____
in Section S _____ T _____ R _____

3. Miscellaneous S _____ T _____ R _____
Property in Sec. S _____ T _____ R _____

Register of Deeds
 BAY COUNTY, MICHIGAN

DEC 30 3 51 PM '97

RECORDED

Register of Deeds Stamp & File Number

4. Lot No. _____, Recorded Plat _____
5. Private Claims _____

I, BRIAN D FERGUSON, in a field survey on MAY 5, 19 97 do hereby state that under requirements of P.A. 74, Michigan P.A. of 1970, the corner points mentioned in lines 1 and 2 above were in conformance with regulations and rules therefore as required in the current manual of survey instructions of the United States Department of the Interior, Bureau of Land Management or by a decree of a Court of Law and/or that the corner points mentioned in lines 3, 4 and 5 above were in conformance with the rules of the Michigan Board of Land Surveyors or by a Decree of a Court of Law; established, re-established, monumented, recovered, found as expressed below:

NOTE: Not more than 2 corners, all in the same town and range, may be recorded on this certificate.

| | A | B | C | D | E | F | G | H | I | J | K | L | M |
|----|----|---|----|---|----|---|----|---|----|---|----|---|----|
| 1 | | | | | | | | | | | | | |
| 2 | 6 | | 5 | | 4 | | 3 | | 2 | | | | |
| 3 | | | | | | | | | | | | | |
| 4 | 7 | | 8 | | 9 | | 10 | | 11 | | 12 | | |
| 5 | | | | | | | | | | | | | |
| 6 | 18 | | 17 | | 16 | | 15 | | 14 | | 13 | | |
| 7 | | | | | | | | | | | | | |
| 8 | 19 | | 20 | | 21 | | 22 | | 23 | | 24 | | |
| 9 | | | | | | | | | | | | | |
| 10 | 30 | | 29 | | 28 | | 27 | | 26 | | 25 | | |
| 11 | | | | | | | | | | | | | |
| 12 | 31 | | 32 | | 33 | | 34 | | 35 | | 36 | | 38 |
| 13 | | | | | | | | | | | | | |

A. Description of original monument and accessories and/or subsequent restoration:

D-13 WOOD POST SET BY JOHN MULLETT IN 1839 - 40
NO EVIDENCE OF ORIGINAL CORNER REMAINS
LCRC RECORDED IN L 002 P 633
NO SURVEYS RECORDED ON THIS CORNER


B. Description of corner evidence found and/or method applied in restoring or reestablishing corner:

D-13 FOUND 3/8" ROD
AGREES WITH LOCATION REFERENCED BY LCRC
LOCATION IS WITHIN .08' OF BEING ON A SPLIT BETWEEN C-13 & E-13
LOCATION IS WITH 10" (SECONDS) OF BEING ON-LINE BETWEEN C-13 & E-13

THIS POSITION IS ACCEPTED AS THE BEST AVAILABLE EVIDENCE OF THE POSITION OF THE ORIGINAL CORNER

C. Description of monument for corner and accessories established to perpetuate locating the position of the corner:

D-13 SET 5/8" ROD W/3" BRASS BAY COUNTY REMONUMENTATION DISK IN MONUMENT BOX
NORTH 27.0' FCE OF 2-1/2" DIA. STEEL POST
N75E 137.45' TOP CTR MBT RISER
N60W 143.10' PK NAIL IN S FCE PWR POLE
SOUTH 8.35' EDGE OF PAVEMENT

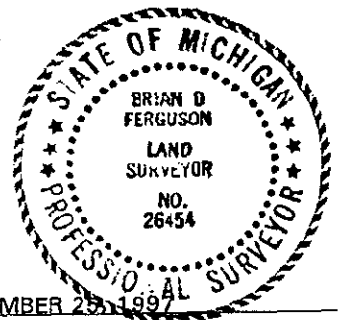

Signed by Brian D Ferguson Date NOVEMBER 25, 1997
Surveyor's Michigan License No. 26454

APPROVED LAND CORNER
P.A. 345 OF 1990 - Bay County
Date 11 Sept 97
MJM
Michael MacDonald P.S.
County Representative