

**SURVEY &
REMONUMENTATION**

APR 23 1998

**BAY COUNTY REMONUMENTATION 1997
LAND CORNER RECORDATION CERTIFICATE
Filing Requirement of Act 74, Mich. P.A. 1970**

SECTION

For corners in

<u>Bay</u> (County)	Located In:	Corner Code #
1. Public Land Survey	T <u>15N</u> R <u>4 E</u>	<u>E-12</u>
	T _____ R _____	_____
	T _____ R _____	_____
	T _____ R _____	_____
2. Property Controlling in Section	S _____ T _____ R _____	_____
	S _____ T _____ R _____	_____
3. Miscellaneous Property in Sec.	S _____ T _____ R _____	_____
	S _____ T _____ R _____	_____

REGISTER OF DEEDS
 BAY COUNTY, MICHIGAN
 Dec 9 10 52 AM '97
 REGISTERED
 Register of Deeds Stamp & File Number

4. Lot No. _____, Recorded Plat _____
 5. Private Claims _____

I, Ronald C. Prevost, in a field survey on 5-12, 1997, do hereby state that under requirements of P.A. 74, Michigan P.A. of 1970, the corner points mentioned in lines 1 and 2 above were in conformance with regulations and rules therefore as required in the current manual of survey instructions of the United States Department of the Interior, Bureau of Land Management or by a decree of a Court of Law and/or that the corner points mentioned in lines 3, 4 and 5 above were in conformance with the rules of the Michigan Board of Land Surveyors or by a Decree of a Court of Law; established, re-established, monumented, recovered, found as expressed below:

A	B	C	D	E	F	G	H	I	J	K	L	M
1												
2	6	5	4	3	2	1						
3												
4	7	8	9	10	11	12						
5												
6	18	17	16	15	14	13						
7												
8	19	20	21	22	23	24						
9												
10	30	29	28	27	26	25						
11												
12	31	32	33	34	35	36						
13												

NOTE: Not more than 2 corners, all in the same town and range, may be recorded on this certificate.

A. Description of original monument and accessories and/or subsequent restoration:


E-12 Post Set By John Burt, 1843
 Elm 9" N.60°E. 31 Lks.
 Ironwood 8" S.63°W. 21 Lks.
 L.C.R.C. L2 P528, Bongiovanni, 1981, set P.K. from MSHD witnesses.
 L.C.R.C L2 P635, Hughes, 1989, 1/2" iron pipe found.
 Act 132 L834 P694 MacDonald, 1978, iron found.
 Act 132 L981 P30 Burgin, 1984 3/4" pipe.

B. Description of corner evidence found and/or method applied in restoring or reestablishing corner:

E-12 Found 5/8" pipe, 5-12-97.
 Recovered three witnesses from L2 P528 that supports position.
 Recovered one witness from L2 P635 that supports position.
 Recovered two witnesses from L834 P694 that supports position.
 Recovered three witnesses from L981 P30 that supports position.
 Measurement North 2643.44 agrees with prev. MDOT distance 2643.37.
 Measurement South 2586.89 agrees with prev. Spicer Dist. 2586.89 & W/T 2586.9
 Peer Group temp approval 5-29-97. Final 6-27-97.
 Monument accepted as best available evidence of the position of the original corner.

C. Description of monument for corner and accessories established to perpetuate locating the position of the corner:

E-12 Replaced 5/8" pipe with 5/8" re-rod, Bay Co. re-mon cap & mon box 7-3-97.
 N.08°W. 64.95 "x" on S end conc. headwall. (Prev. 64.95).
 N.22°E. 54.50 "x" on S end conc. headwall. (Prev. 54.39).
 N.75°E. 52.41 nail S. face 14" Apple.
 N.85°E. 74.53 nail N. face 20" Pine.
 S.70°W. 33.73 nail N. face P. pole. (Prev. 33.69)

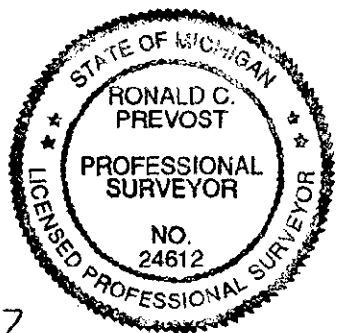

Signed by Ronald C. Prevost
 Ronald C. Prevost
 Surveyor's Michigan License No. 24612

Date 11-10-97

APPROVED LAND CORNER
 P.A. 345 OF 1990 - Bay County
 Date 27 June 97
MTH
 Michael MacDonald P.S.
 County Representative