


SURVEY & REMONUMENTATION

APR 23 1998

**BAY COUNTY REMONUMENTATION 1997
LAND CORNER RECORDATION CERTIFICATE
Filing Requirement of Act 74, Mich. P.A. 1970**

SECTION
For corners in

<u>Bay</u> (County)	Located In:	Corner Code #
1. Public Land Survey	T <u>15N</u> R <u>4E</u>	<u>E-13</u>
	T _____ R _____	_____
	T _____ R _____	_____
	T _____ R _____	_____
2. Property Controlling in Section	S _____ T _____	_____
	S _____ T _____	_____
3. Miscellaneous Property in Sec.	S _____ T _____	_____
	S _____ T _____	_____

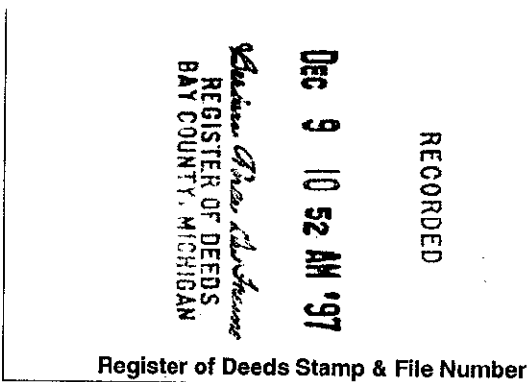

4. Lot No. _____, Recorded Plat _____
5. Private Claims _____

I, Ronald C. Prevost, in a field survey on 5-12, 1997 do hereby state that under requirements of P.A. 74, Michigan P.A. of 1970, the corner points mentioned in lines 1 and 2 above were in conformance with regulations and rules therefore as required in the current manual of survey instructions of the United States Department of the Interior, Bureau of Land Management or by a decree of a Court of Law and/or that the corner points mentioned in lines 3, 4 and 5 above were in conformance with the rules of the Michigan Board of Land Surveyors or by a Decree of a Court of Law; established, re-established, monumented, recovered, found as expressed below:

NOTE: Not more than 2 corners, all in the same town and range, may be recorded on this certificate.

	A	B	C	D	E	F	G	H	I	J	K	L	M
1													
2	6		5		4		3		2		1		
3													
4	7		8		9		10		11		12		
5													
6	18		17		16		15		14		13		
7													
8	19		20		21		22		23		24		
9													
10	30		29		28		27		26		25		
11													
12	31		32		33		34		35		36		
13													

A. Description of original monument and accessories and/or subsequent restoration:

E-13 Post set by John Burt, 1843. Closing from North.
Sugar 14 N.23°E. 19 Lks.
Beech 12 N.10°W. 26 Lks.
LCRC L2 P528, Bongiovanni, 1981.
LCRC L2 P539, Ledy, 1981. Wrong Twp. recorded in error.
LCRC L2 P635, Hughes, 1989.
Act 132 L834 P694, MacDonald, 1978, fnd 1/2" iron.

B. Description of corner evidence found and/or method applied in restoring or reestablishing corner:

E-13 Found 3/8" rod 5-12-97 and 3/4" solid iron bar directly below.
Recovered two witnesses from L2 P528 that supports position.
Recovered one witness from L2 P635 that supports position.
Recovered one witness from L834 P694 that supports position.
Peer group approval 7-31-97.
Monument accepted as best available evidence of the position of the original corner.

C. Description of monument for corner and accessories established to perpetuate locating the position of the corner:

E-13 Replaced 3/8" rod/ 3/4" solid bar with 5/8" re-rod, Bay Co. re-mon cap and mon box 8-21-97.
N.20°W. 68.70 nail & ribbon W. face P. pole. (68.60 L2 P635).
S.45°W. 70.37 nail & cap E face 10" Spruce.
S.15°W. 42.74 nail & cap E. face 15" Apple. (43.25' 7" Apple L2 P528).
S.40°E. 53.96 nail & cap NE face 15" Apple.
S.65°E. 82.82 nail & cap N face 18" Apple. (83.42 8" Apple L2 P528).



Signed by Ronald C. Prevost
Ronald C. Prevost

Date 11-10-97

Surveyor's Michigan License No. 24612

APPROVED LAND CORNER
P.A. 345 OF 1990 - Bay County
Date 31 July 97
MJM
Michael MacDonald P.S.
County Representative