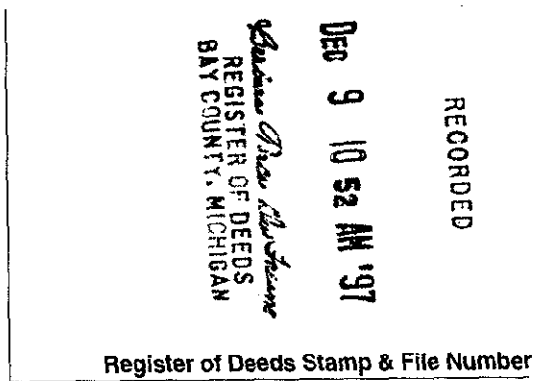


SURVEY & REMONUMENTATION BAY COUNTY REMONUMENTATION 1997
LAND CORNER RECORDATION CERTIFICATE
 Filing Requirement of Act 74, Mich. P.A. 1970

APR 23 1998

For corners in SECTION _____

Bay (County)	Located In:	Corner Code #
1. Public Land Survey	T 15N R 4E	1-12
	T _____ R _____	_____
	T _____ R _____	_____
	T _____ R _____	_____
2. Property Controlling in Section	S _____ T _____ R _____	_____
	S _____ T _____ R _____	_____
3. Miscellaneous Property in Sec.	S _____ T _____ R _____	_____
	S _____ T _____ R _____	_____


 REGISTER OF DEEDS
 BAY COUNTY, MICHIGAN
 DEC 9 10 52 AM '97
 RECORDED

4. Lot No. _____, Recorded Plat _____
 5. Private Claims _____

I, Ronald C. Prevost, in a field survey on 5-13, 1997 do hereby state that under requirements of P.A. 74, Michigan P.A. of 1970, the corner points mentioned in lines 1 and 2 above were in conformance with regulations and rules therefore as required in the current manual of survey instructions of the United States Department of the Interior, Bureau of Land Management or by a decree of a Court of Law and/or that the corner points mentioned in lines 3, 4 and 5 above were in conformance with the rules of the Michigan Board of Land Surveyors or by a Decree of a Court of Law; established, re-established, monumented, recovered, found as expressed below:

	A	B	C	D	E	F	G	H	I	J	K	L	M
1													
2	6		5		4		3		2		1		
3													
4	7		8		9		10		11		12		
5													
6	18		17		16		15		14		13		
7													
8	19		20		21		22		23		24		
9													
10	30		29		28		27		26		25		
11													
12	31		32		33		34		35		36		
13													

NOTE: Not more than 2 corners, all in the same town and range, may be recorded on this certificate.

A. Description of original monument and accessories and/or subsequent restoration:

- I-12 Post set by John Burt, 1843.
 Lynn 10" S.44E. 18 Lks.
 Beech 14" N.59W. 10 Lks.
 LCRC L2 P365 MacDonald, 1976, iron bar.
 LCRC L2 P638 Hughes, 1989, 3/8" iron bar found.
 Act 132 L758 P363 McGinnis, 1975 1" iron bar, same witnesses as L2 P365.

B. Description of corner evidence found and/or method applied in restoring or reestablishing corner:

- I-12 Found 3/8" rod. Boat spike below 5-13-97.
 Recovered one witness from L2 P365 that supports position.
 Recovered one witness from L2 P638 that supports position same wit.
 Measurement North 2617.37 agrees with W/T & EDM. previous dist. 2617.46.
 Peer group approval 7-31-97.
 Monument accepted as best available evidence of the position of the original corner.

C. Description of monument for corner and accessories established to perpetuate locating the position of the corner:

- I-12 Replaced 3/8" rod with 5/8" re-rod, Bay Co. re-mon cap & mon box. 8-21-97.
 S.35°W. 78.28 nail & cap E. face P. pole. (prev. 78.0 L2 P365)(Prev. 78.24 L2 P638)
 N.70°W. 54.57 nail & cap S. face P. pole.
 N.45°E. 117.18 nail & cap SE face P. pole.
 N.25°E. 96.49 nail & cap SE face guy pole.



Signed by Ronald C. Prevost
 Ronald C. Prevost
 Surveyor's Michigan License No. 24612

Date 11-10-97

APPROVED LAND CORNER
 P.A. 345 OF 1990 - Bay County
 Date 31 July 97
MJM
 Michael MacDonald P.S.
 County Representative