

SURVEY & REMONUMENTATION

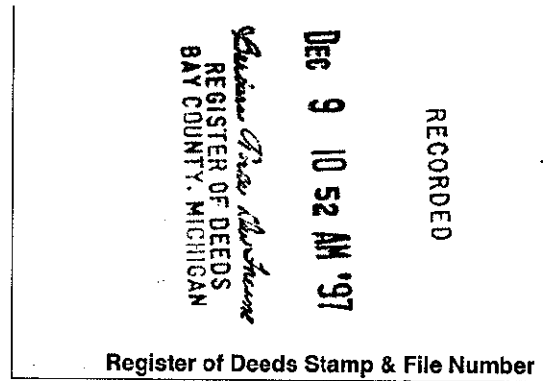
APR 23 1998

**BAY COUNTY REMONUMENTATION 1997
LAND CORNER RECORDATION CERTIFICATE
Filing Requirement of Act 74, Mich. P.A. 1970**

SECTION

For corners in

<u>Bay</u> (County)	Located In:	Corner Code #
1. Public Land Survey	T <u>15N</u> R <u>4 E</u>	<u>L-11</u>
	T _____ R _____	_____
	T _____ R _____	_____
	T _____ R _____	_____
2. Property Controlling in Section	S _____ T _____	R _____
	S _____ T _____	R _____
3. Miscellaneous Property in Sec.	S _____ T _____	R _____
	S _____ T _____	R _____


 REGISTER OF DEEDS
 BAY COUNTY, MICHIGAN
 Dec 9 10 52 AM '97
 RECORDED

4. Lot No. _____, Recorded Plat _____
 5. Private Claims _____

I, Ronald C. Prevost, in a field survey on 5-14, 1997 do hereby state that under requirements of P.A. 74, Michigan P.A. of 1970, the corner points mentioned in lines 1 and 2 above were in conformance with regulations and rules therefore as required in the current manual of survey instructions of the United States Department of the Interior, Bureau of Land Management or by a decree of a Court of Law and /or that the corner points mentioned in lines 3, 4 and 5 above were in conformance with the rules of the Michigan Board of Land Surveyors or by a Decree of a Court of Law; established, re-established, monumented, recovered, found as expressed below:

NOTE: Not more than 2 corners, all in the same town and range, may be recorded on this certificate.

	A	B	C	D	E	F	G	H	I	J	K	L	M
1													
2		6		5		4		3		2		1	
3													
4		7		8		9		10		11		12	
5													
6		18		17		16		15		14		13	
7													
8		19		20		21		22		23		24	
9													
10		30		29		28		27		26		25	
11													
12		31		32		33		34		35		36	
13													

A. Description of original monument and accessories and/or subsequent restoration:

L-11 Post set by John Mullet, 1840.
 B. Ash 10" N.85°W. 42 Lks.
 Tamarack 12" East 60 Lks.
 LCRC L2 P644, Hughes, 1989, 5/8" iron in mon box.

B. Description of corner evidence found and/or method applied in restoring or reestablishing corner:

L-11 Found 1/2" rod in mon box, 5-14-97.
 Recovered three witnesses from L2 P644 that support position.
 Numerous recorded surveys with same witnesses as L2 P644.
 Measurement West 2629.69 agrees with previous w/t dist 2629.78.
 Measurement West 2629.69 agrees with previous Spicer dist 2629.69.
 Measurement East 2629.69 agrees with previous w/t dist 2629.78.
 Temporary Peer Group approval 5-29-97. Final approval 6-27-97.
 Monument accepted as best available evidence of the position of the original corner.

C. Description of monument for corner and accessories established to perpetuate locating the position of the corner:

L-11 Raised existing box to surface and replaced 1/2" rod with 5/8" re-rod, Bay Co. bronze re-mon cap. 6-4-97.
 N.30°E. 99.03 SE cor. hse foundation. (99.02 L2 P644).
 N.60°E. 95.72 R.R. spike S. face P. pole. (95.69 L2 P644)
 S.30°E. 44.46 nail & cap NE face T pole.
 S.25°E. 69.92 P.K. nail E. face P. pole (69.88 L2 P644).

Signed by Ronald C. Prevost
 Ronald C Prevost

Date 11-10-97



Surveyor's Michigan License No. 24612

APPROVED LAND CORNER
 P.A. 345 OF 1990 - Bay County
 Date 27 June 97
MJM