

SURVEY & REMONUMENTATION

**BAY COUNTY REMONUMENTATION 1997
LAND CORNER RECORDATION CERTIFICATE
Filing Requirement of Act 74, Mich. P.A. 1970**

APR 23 1998

For corners in SECTION _____

Bay (County)	Located In:	Corner Code #
1. Public Land Survey	T 15N R 4E	M-11
	T (15N R 5E	A-11)
	T _____ R _____	_____
	T _____ R _____	_____
2. Property Controlling in Section	S _____ T _____ R _____	_____
	S _____ T _____ R _____	_____
3. Miscellaneous Property in Sec.	S _____ T _____ R _____	_____
	S _____ T _____ R _____	_____

RECORDED

Dec 9 10 51 AM '97

Register of Deeds
**REGISTER OF DEEDS
BAY COUNTY, MICHIGAN**

Register of Deeds Stamp & File Number

4. Lot No. _____, Recorded Plat _____
5. Private Claims _____

I, Ronald C. Prevost, in a field survey on 5-14, 1997 do hereby state that under requirements of P.A. 74, Michigan P.A. of 1970, the corner points mentioned in lines 1 and 2 above were in conformance with regulations and rules therefore as required in the current manual of survey instructions of the United States Department of the Interior, Bureau of Land Management or by a decree of a Court of Law and/or that the corner points mentioned in lines 3, 4 and 5 above were in conformance with the rules of the Michigan Board of Land Surveyors or by a Decree of a Court of Law; established, re-established, monumented, recovered, found as expressed below:

	A	B	C	D	E	F	G	H	I	J	K	L	M
1													
2	6			5		4		3		2		1	
3													
4	7			8		9		10		11		12	
5													
6	18			17		16		15		14		13	
7													
8	19			20		21		22		23		24	
9													
10	30			29		28		27		26		25	
11													
12	31			32		33		34		35		36	
13													

NOTE: Not more than 2 corners, all in the same town and range, may be recorded on this certificate.

A. Description of original monument and accessories and/or subsequent restoration:


M-11 Post set by John Mullet, 1839.
W. Oak 16 S.29 W 40 Lk.
Y. Pine 18 N.75 W. 23 Lk.
LCRC L2 P644, Hughes, 1989, fnd 3/8" I bar/mon box from prev. wit's.
Act 132 L794 P27, McGinnis, 1976, fnd
Corner M-11, T.15 N.-R.4 E., is common with A-11, T.15 N.-R.5 E.

B. Description of corner evidence found and/or method applied in restoring or reestablishing corner:

M-11 Found 3/8" rod in small mon box 5-14-97.
Recovered two witnesses from L2 P644 that support position.
Recovered two witnesses from L794 P27 that support position. (same)
Measurement South 2648.52 agrees with previous w/t dist. 2648.64/2648.5.
Measurement West 2629.69 agrees with previous w/t dist. 2629.78.
Peer Group approval 7-31-97.
Monument accepted as best available evidence of the position of the original corner.

C. Description of monument for corner and accessories established to perpetuate locating the position of the corner:

M-11 Replaced 3/8" rod with 5/8" re-rod, Bay Co. bronze re-mon cap and new mon box. 8-13-97.
S.80°E. 69.93 ctr hyd (69.93 L2 P644)(70.00 L794 P27).
S.50°E. 64.36 nail & cap S.W. face P. pole.
S.25°W. 87.12 nail & cap S.E. face 30" Willow.
S.65°W. 70.52 nail & cap N.W. face P. pole (70.52 L2 P644)(70.00 face L794 P27).

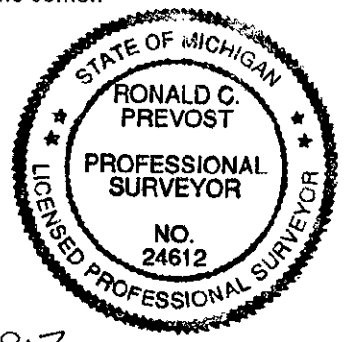

Signed by Ronald C. Prevost
Ronald C. Prevost
Surveyor's Michigan License No. 24612

Date 12-3-97

APPROVED LAND CORNER
P.A. 345 OF 1990 - Bay County
Date 31 July 97
M.M.
Michael MacDonald P.S.
County Representative