

REMONUMENTATION

MAY 20 1997

REMON. COR. E-11, GARFIELD TWP.
LAND CORNER RECORDATION CERTIFICATE
Filing Requirement of Act 74, Mich. P.A. 1970

For corners in
Bay _____
(County)

Located in: Corner Code #
T 16N R 3E E-11
T _____ R _____
T _____ R _____
T _____ R _____
S _____ T _____ R _____
S _____ T _____ R _____
S _____ T _____ R _____
S _____ T _____ R _____

- 1. Public Land Survey
- 2. Property Controlling in Section
- 3. Miscellaneous Property In Sec.
- 4. Lot No. _____, Recorded Plat _____
- 5. Private Claims _____

003 288

RECORDED

OCT 29 4 33 PM '96

Register of Deeds State of Michigan
BAY COUNTY, MICHIGAN


I, _____, in a field survey on _____, 1996, do hereby certify that under requirements of P.A. 74, Michigan P.A. of 1970, the corner points mentioned on lines 1 and 2 above were in conformance with regulations and rules therefore as required in the current manual of survey instructions of the United States Department of the interior, Bureau of Land Management or by a decree of a Court of Law and/or that the corner points mentioned in lines 3, 4 and 5 above were in conformance with the rules of the Michigan Board of Land Surveyors or by a Decree of a Court of Law; re-established, monumented, re-monumented, recovered, found as expressed below:

NOTE: Not more than 4 corners, all in the same town and range, may be recorded on this certificate.

	A	B	C	D	E	F	G	H	I	J	K	L	M
2	6	5	4	3	2	1							
3													
4	7	8	9	10	11	12							
5													
6	18	17	16	15	14	13							
7													
8	19	20	21	22	23	24							
9													
10	30	29	28	27	26	25							
11													
12	31	32	33	34	35	36							
13													

A. Description of original monument and accessories and/or subsequent restoration:

E-11 Corner common to Sections 28, 29, 32 and 33
1831, R. Clark, set post, GLO notes
1967, Edmands Engineering breakdown of Sections 28, 29, 32, 33, set concrete nail
1972, L. McGinnis, PS #18999, LCRC, L-001, P-109, found iron

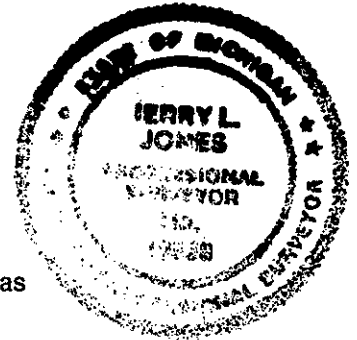

WITNESS NOTE: Witnesses from above surveys and LCRC's are available in dossier file; which was presented to peer review committee.

B. Description of corner evidence found and/or method applied in restoring or reestablishing corner:

E-11 Corner common to Sections 28, 29, 32 and 33
Found rod and cap #21575, D. Ledy, per surveys by Edmands Engineering and L. McGinnis and LCRC by L. McGinnis

C. Description of monument for corner and accessories established to perpetuate locating the position of the corner:

E-11 Corner common to Sections 28, 29, 32 and 33
Found rod and cap #21575, per surveys by Edmands Engineering, L. McGinnis and LCRC by L. McGinnis, replaced rod with 5/8" rod and brass cap stamped Bay County Remonumentation PS 19838, in mon box; and is accepted as the best available evidence of the position of the accepted corner
South, 32.36', chiseled "+" in top project marker
S 60 Deg E, 55.38', centerline top telephone box
S 50 Deg W, 64.54', nail and plastic disc in power pole (65.01 recorded)
N 50 Deg W, 44.20', chiseled "+" in N end concrete pipe
North, 1.5' centerline E & W road
East, 4', centerline road to north

APPROVED LAND CORNER
P.A. 345 OF 1980 - Bay County
Date 27 June 96
MJM
Michael MacDonald P.S.
County Representative

Signed by Jerry L. Jones Date 10/17/96
Surveyor's Michigan License No. 19838