
· · · · currui a Temoni parivattor.

REMON. COR. F-11, GARFIELD TWP. MAY 2 0 1907 LAND CORNER RECORDATION CERTIFICATE Filing Requirement of Act 74, Mich. P.A. 1970 003 290 MARKINGSION For corners in Bay Located in: Corner Code # (County) T16NR3E 1. Public Land Survey F-11 R S 2. Property Controlling in Section 3. Miscellaneous Register of Deeds Stamp & Property in Sec. , Recorded Plat 4. Lot No. 5. Private Claims ABCDEFGHIJKLM

I, <u>JERRY JONES</u>, in a field survey on <u>MAY 23</u>, 1996, do hereby certify that under requirements of P.A. 74, Michigan P.A of 1970, the corner points mentioned on lines 1 and 2 above were in conformance with regulations and rules therefore as required in the current manual of survey instructions of the United States Department of the interior, Bureau of Land Management or by a decree of a Court of Law and/or that the corner points mentioned in lines 3, 4 and 5 above were in conformance with the rules of the Michigan Board of Land Surveyors or by a Decree of a Court of Law; re-established, monumented, re-monumented, recovered, found as expressed below:

NOTE: Not more than 4 corners, all in the same town and range, may be recorded on this certificate.

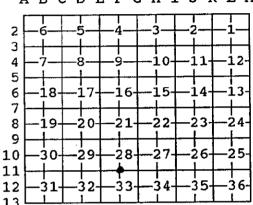


- A. Description of original monument and accessories and/or subsequent restoration:
- F-11 Corner common to Sections 28 and 33

1831, R. Clark, set post, GLO notes

1967, Edmands Engineering, breakdown for Sections 28 and 33, found iron

1983, D. Ledy, (found wood post) (set 1/2" bar)

WITNESS NOTE: Witnesses from above surveys and LCRC's are available in dossier file; which was presented to peer review committee.

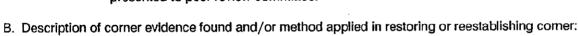

F-11 Corner common to Sections 28 and 33

Found 1/2" rod and cap per surveys by D. Ledy

- C. Description of monument for corner and accessories established to perpetuate locating the position of the corner:
- F-11 Corner common to Sections 28 and 33

Found 1/2" rod and cap per surveys by D. Ledy, replaced rod with 5/8" rod and brass cap stamped Bay County Remonumentation PS 19838, and is the best available evidence of the position of the accepted corner.

S 5 Deg W, 51.20', nail and plastic disc in power pole (rec 51.20')

N 10 Deg W, 97.15', SE corner house

N 2 Deg E, 138.70', nail and plastic disc in power pole

N 60 Deg W, 69.8', center line 24" Poplar

S 70 Deg, E, 177.99', nail and plastic disc in power pole

APPROVED LAND CORNER
P.A. 345 OF 1990 - Bay County
Date 37 June 16

MJM
Michael MacDonald P.S.
County Representative

Signed by Quey J. Jones

Date 10/17/96

Form approved by Michigan State Board of Land Surveyors, Jan. 28, 1971

Surveyor's Michigan License No. 19838

Revised May 14, 1971

Revised Jan., 1983