

MAY 26 1997

REMON. COR. H-13, GARFIELD TWP. LAND CORNER RECORDATION CERTIFICATE Filing Requirement of Act 74, Mich. P.A. 1970

003 294

For corners in Bay (County)

- 1. Public Land Survey T 16N R 3E H-13
2. Property Controlling in Section S T R
3. Miscellaneous Property in Sec. S T R

- 4. Lot No. Recorded Plat
5. Private Claims

Register of Deeds Stamp & File Number. REGISTER OF DEEDS BAY COUNTY, MICHIGAN. DEC 19 8 41 AM '96. RECORDED


I, JERRY JONES, in a field survey on OCT 1, 1996, do hereby certify that under requirements of P.A. 74, Michigan P.A. of 1970, the corner points mentioned on lines 1 and 2 above were in conformance with regulations and rules therefore as required in the current manual of survey instructions of the United States Department of the interior, Bureau of Land Management or by a decree of a Court of Law and/or that the corner points mentioned in lines 3, 4 and 5 above were in conformance with the rules of the Michigan Board of Land Surveyors or by a Decree of a Court of Law; re-established, monumented, re-monumented, recovered, found as expressed below:

Grid table with columns A-M and rows 2-13. Contains numbers 1-36 in a grid pattern.

NOTE: Not more than 4 corners, all in the same town and range, may be recorded on this certificate.

A. Description of original monument and accessories and/or subsequent restoration:

- H-13 S 1/4 corner Section 34
1830's GLO notes
1986, D. Burgin, rec survey, L-1014, P-402, found capped iron #18999 (set "T" bar on top)
1987, D. Burgin, rec survey, L-1066, P-743, found capped iron
1992, P. Ciosek, LCRC, L-3, P-07

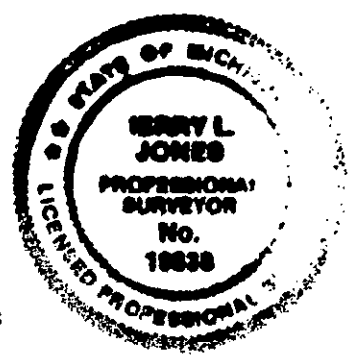

WITNESS NOTE: Witnesses from above surveys and LCRC's are available in dossier file; which was presented to peer review committee.

B. Description of corner evidence found and/or method applied in restoring or reestablishing corner:

- H-13 S 1/4 corner Section 34
Found "T" bar and cap # 29240 per surveys by D. Burgin and LCRC by P. Ciosek

C. Description of monument for corner and accessories established to perpetuate locating the position of the corner:

- H-13 S 1/4 corner Section 34
Found "T" bar and cap # 29240 per surveys by D. Burgin and LCRC by P. Ciosek, replaced "T" bar with 5/8" rod and brass cap stamped Bay County Remonumentation PS 19838 in mon box, and is accepted as the best available evidence of the position of the accepted corner.
South, 97.87', nail and BC disc in 10' Elm
S 60 Deg W, 36.39', chiseled "+" in W end CMP (1992 wit.)
S 45 Deg E, 26.31', chiseled "+" in E end CMP (1992 wit.)
N 75 Deg E, 128.07', nail in power pole
North, 1.4', centerline bit road
East, 17.43', 3/8" rod and cap (H-1, T15N-R3E) (1992 wit.)

APPROVED LAND CORNER P.A. 345 OF 1990 - Bay County Date 18 Oct 96 M.J.M. Michael MacDonald P.S. County Representative

Signed by Jerry L. Jones Date 12/04/96