

REMONUMENTATION

MAY 20 1997

REMONUMENTATION

1996 BAY COUNTY REMONUMENTATION LAND CORNER RECORDATION CERTIFICATE Filing Requirement of Act 74, Mich. P.A. 1970

003 319

For corners in

Table with columns: Bay (County), Located In, Corner Code #. Row 1: Public Land Survey, T 16 N. R 3 E., J-11, K-11.

Register of Deeds Stamp & File Number. DEC 27 2 32 PM '96. RECORDED. Bay County, Michigan.

4. Lot No. , Recorded Plat
5. Private Claims

I, Ronald C. Prevost, in a field survey on 9-26-K-11; 9-25-J-11, 19 96 do hereby state that under requirements of P.A. 74, Michigan P.A. of 1970, the corner points mentioned in lines 1 and 2 above were in conformance with regulations and rules therefore as required in the current manual of survey instructions of the United States Department of the Interior, Bureau of Land Management or by a decree of a Court of Law and /or that the corner points mentioned in lines 3, 4 and 5 above were in conformance with the rules of the Michigan Board of Land Surveyors or by a Decree of a Court of Law; established, re-established, monumented, recovered, found as expressed below:

Grid table with columns A-L and rows 1-13. Contains numbers 6-36.

NOTE: Not more than 2 corners, all in the same town and range, may be recorded on this certificate.

A. Description of original monument and accessories and/or subsequent restoration:

J-11 Post set by Mullet, 1846. Co. Surveyors Map, 1909, Geo. Turner, indicates old stake found and not at mid point of N. Line Section 35. L.C.R.C. L1 P63, 1971 fnd 5/8" rod inside 2" pipe. L.C.R.C. L2 P35, 1973 fnd 5/8" rod inside 2" pipe. L.C.R.C. L2 P273, 1976 fnd 5/8" rod inside 2" pipe.

K-11 Post set by Mullet, 1846. Co. Surveyors Map, 1908, Geo. Turner indicates found old stake. Co. Surveyors Map, 1909, Geo. Turner, indicates found old stake. L.C.R.C. L1 P63, 1971, 5/8" rod. L.C.R.C. L1, P105, 1972 iron. L.C.R.C. L2, P33, 1973 5/8" iron rod

B. Description of corner evidence found and/or method applied in restoring or reestablishing corner:

J-11 Found 5/8" iron inside 2" pipe, 9-25-96. Witnesses from L.C.R.C. L1 P63 & L2 P35 - gone L.C.R.C. L2 P273, N.45°E. 137.25 to SW cor. House (M 137.30)

K-11 Found 5/8" iron (Re-Bar) 9-26-96 L.C.R.C. L1 P63 SW. 58' P. Pole, (S45°W. 58.52 tag in SE face P. Pole M) L.C.R.C. L1 P105 SW 58.52 tag in P. Pole (58.52 M) L.C.R.C. L2 P33 SW 58.52 nail & disc PP (58.52 M) Approved by Peer Group 10-18-96


C. Description of monument for corner and accessories established to perpetuate locating the position of the corner:

J-11 Replaced 5/8" iron with 5/8" bar, Bay Co. Re-Mon cap set Mon box 11-29-96. N.45°E. 137.30 to SW cor house. N.40°W. 54.15 set nail & Bay Co. tag in E face twin 12" Elm S.15°W. 29.25 set nail & Bay Co. tag in W. face 15" Poplar S.45°W. 45.80 set nail & Bay Co. tag in NW. Face 18" Poplar

K-11 Replaced 5/8" bar with 5/8" bar, Bay Co. Re-Mon cap, set mon box on 11-29-96. S.45°W. 58.52 to tag in SE. face p. pole S.45°E. 40.6 to rd. sign. S.40°E. 59.85 P.K. in SW. face p. pole S.45°E. 45.40 ctr. tel pole. S.40°W. 65.40 nail & Bay Co. tag in SE. face 8" oak.

Signed by Ronald C. Prevost Surveyor's Michigan License No. 24612

Date 12-23-96

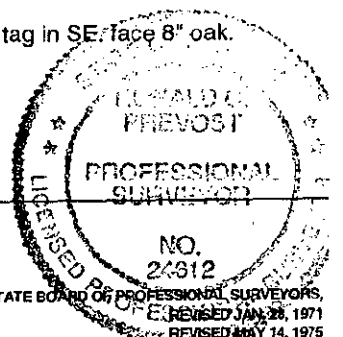

APPROVED LAND CORNER P.A. 345 OF 1990 - Bay County Date 18 Oct 96 Michael MacDonald P.S. County Representative