

**BAY COUNTY REMONUMENTATION
LAND CORNER RECORDATION CERTIFICATE
Filing Requirement of Act 74, Mich. P.A. 1970**

Division of State Administration
 REGISTER OF DEEDS
 BAY COUNTY, MICHIGAN

DEC 30 3 38 PM '97

RECORDED

For corners in

<u>BAY COUNTY</u> (County)	Located In:	Corner Code #
1. Public Land Survey	T <u>16N</u> R <u>3E</u>	<u>K-2</u>
	T _____ R _____	_____
	T _____ R _____	_____
	T _____ R _____	_____
2. Property Controlling in Section	S _____ T _____ R _____	_____
	S _____ T _____ R _____	_____
3. Miscellaneous Property in Sec.	S _____ T _____ R _____	_____
	S _____ T _____ R _____	_____

Register of Deeds Stamp & File Number

4. Lot No. _____, Recorded Plat _____

5. Private Claims _____

A	B	C	D	E	F	G	H	I	J	K	L	M
1												
2	6		5		4		3		2	●	1	
3												
4	7		8		9		10		11		12	
5												
6	18		17		16		15		14		13	
7												
8	19		20		21		22		23		24	
9												
10	30		29		28		27		26		25	
11												
12	31		32		33		34		35		36	
13												

I, Paul M. Ciosek, in a field survey on JULY 24, 19 97 do hereby state that under requirements of P.A. 74, Michigan P.A. of 1970, the corner points mentioned in lines 1 and 2 above were in conformance with regulations and rules therefore as required in the current manual of survey instructions of the United States Department of the Interior, Bureau of Land Management or by a decree of a Court of Law and /or that the corner points mentioned in lines 3, 4 and 5 above were in conformance with the rules of the Michigan Board of Land Surveyors or by a Decree of a Court of Law; established, re-established, monumented, recovered, found as expressed below:

NOTE: Not more than 2 corners, all in the same town and range, may be recorded on this certificate.

A. Description of original monument and accessories and/or subsequent restoration:


- K-2
1. SET POST BY J. MULLETT D.S. RESURVEY JUNE 1846
HEMLOCK 6" S 75° E 36 LINKS
BEECH 6" N 51° W 35 LINKS
 2. SURVEY, BY EDMANDS, UNRECORDED, JOB #6097, 1969, NO CALL
 3. SURVEY, L. 711, P. 583, MCGINNIS, (6/1/73) FND PIPE OVER 3/8" IRON
 4. LCRC, L. 1, P. 589, MCGINNIS, (10/12/73) NO CALL
 5. SURVEY, L. 827, P. 4, MCGINNIS, (8/1/77) FOUND 3/8" REROD
 6. LCRC, L. 4, P. 7, RICHARDSON, (4/17/97) FND 1/2" ROD PER L. 1, P. 557, NNW 138.25' TO NAIL IN 8" PINE

B. Description of corner evidence found and/or method applied in restoring or reestablishing corner:

K-2
SEARCHED THE APPARENT LOCATION OF THE CORNER AND FOUND 3/8" REROD 0.1' SE OF THE CENTER OF A 4" x 4" ROUNDED WOOD POST 9" BELOW THE GRAVEL SURFACE. FOUND A 3/4" PIPE 1.3' BELOW THE GRAVEL SURFACE AND 0.1' EAST AND 0.5' SOUTH OF THE 3/8" IRON. ACCEPTED THE 3/8" REROD IN WOOD POST AS THE BEST AVAILABLE EVIDENCE OF THE POSITION OF THE ORIGINAL CORNER.


C. Description of monument for corner and accessories established to perpetuate locating the position of the corner:

K-2
REPLACED FOUND 3/8" REROD WITH 5/8" x 24" REROD WITH BAY COUNTY REMONUMENTATION CAP WITH 3/16" DRILL HOLE IN MONUMENT BOX.
N 40°E 27.30' SET CAPPED 3/8" REROD
S 40°E 26.23' SET CAPPED 3/8" REROD
S 30°W 15.24' SET CAPPED 3/8" REROD
N 20°W 14.24' SET CAPPED 3/8" REROD.
WEST 10.45' (10.3' R.) SOUTH LEG OF SIGN
S 50°E 58.83' SET NAIL/TAG IN FACE OF UTILITY POLE
S 30°E 78.28' SET NAIL/TAG IN NE FACE OF 12" HICKORY
N 55°E 42.76' SET NAIL/TAG IN S FACE OF 4" X 4" SQUARE WOOD POST
WEST 15.24' SET NAIL/TAG IN N FACE 6" ELM IN CLUMP

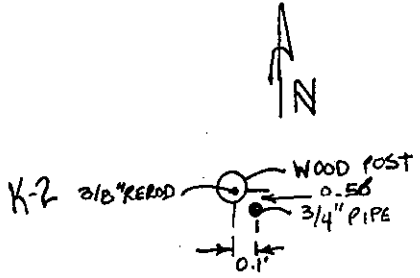

Signed by Paul M. Ciosek
Surveyor's Michigan License No. 25835

Date 12/22/97

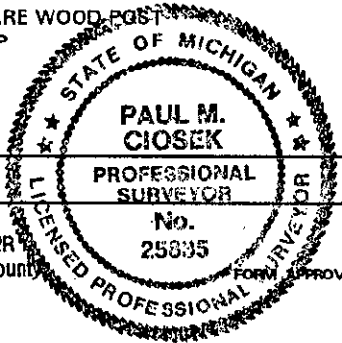

FIELD BOOK , PAGE 10.

APPROVED LAND CORNER
P.A. 345 OF 1990 - Bay County
Date 31 July 97
MJM
Michael MacDonald P.S.

004 69