

**BAY COUNTY REMONUMENTATION
LAND CORNER RECORDATION CERTIFICATE
Filing Requirement of Act 74, Mich. P.A. 1970**

For corners in

<u>BAY COUNTY</u> (County)	Located In:	Corner Code #
1. Public Land Survey	<u>T16N R3E</u>	<u>K-3</u>
	T <u> </u> R <u> </u>	<u> </u>
	T <u> </u> R <u> </u>	<u> </u>
	T <u> </u> R <u> </u>	<u> </u>
2. Property Controlling in Section	S <u> </u> T <u> </u> R <u> </u>	<u> </u>
	S <u> </u> T <u> </u> R <u> </u>	<u> </u>
3. Miscellaneous Property in Sec.	S <u> </u> T <u> </u> R <u> </u>	<u> </u>
	S <u> </u> T <u> </u> R <u> </u>	<u> </u>

Register of Deeds
 REGISTER OF DEEDS
 BAY COUNTY, MICHIGAN

Dec 30 3 32 PM '97

RECORDED

Register of Deeds Stamp & File Number

4. Lot No. _____, Recorded Plat _____

5. Private Claims _____

I, Paul M. Ciosek, in a field survey on JULY 23, 1997 do hereby state that under requirements of P.A. 74, Michigan P.A. of 1970, the corner points mentioned in lines 1 and 2 above were in conformance with regulations and rules therefore as required in the current manual of survey instructions of the United States Department of the Interior, Bureau of Land Management or by a decree of a Court of Law and /or that the corner points mentioned in lines 3, 4 and 5 above were in conformance with the rules of the Michigan Board of Land Surveyors or by a Decree of a Court of Law; established, re-established, monumented, recovered, found as expressed below:

A	B	C	D	E	F	G	H	I	J	K	L	M
1												
2	6	5	4	3	2	1						
3												
4	7	8	9	10	11	12						
5												
6	18	17	16	15	14	13						
7												
8	19	20	21	22	23	24						
9												
10	30	29	28	27	26	25						
11												
12	31	32	33	34	35	36						
13												

NOTE: Not more than 2 corners, all in the same town and range, may be recorded on this certificate.

A. Description of original monument and accessories and/or subsequent restoration:

- K-3
- POST SET BY J. MULLETT D.S., RESURVEY JUNE 1846
ELM 10" N 80°E 16 LINKS
ELM 8" S 20°E 24 LINKS
 - SURVEY, BY EDMANDS, UNRECORDED, JOB #6097, 1969, NO CALL
 - SURVEY, L. 660, P. 323, DELAMATER, (8/6/71) FOUND IRON
 - LCRC, L. 1, P. 273, GOSS, (12/21/72) FND IRON
 - SURVEY, L. 711, P. 583, MCGINNIS, (6/1/73) FND 3/8" REROD
 - SURVEY, L. 1042, P. 92, MCGINNIS, (12/11/86) NO CALL, NW 66.75' TO TAG IN 24" TREE

B. Description of corner evidence found and/or method applied in restoring or reestablishing corner:

K-3
SEARCHED THE APPARENT LOCATION OF THE CORNER AND FOUND A 3/4" PIPE AT THE SURFACE OF THE ROAD. PULLED THE PIPE AND EXCAVATED THE LOCATION AND FOUND NO OTHER OBJECTS IN THE AREA. HIT CLAY AT 1.5' BELOW THE ROAD SURFACE. ACCEPTED THE 3/4" PIPE AS THE BEST AVAILABLE EVIDENCE OF THE POSITION OF THE ORIGINAL CORNER.


C. Description of monument for corner and accessories established to perpetuate locating the position of the corner:

K-3
REPLACED THE FOUND 3/4" PIPE WITH A 5/8" X 24" REROD WITH A BAY COUNTY REMONUMENTATION CAP WITH 3/16" DRILL HOLE IN MONUMENT BOX.
N 45°E 28.47' SET CAPPED 3/8" REROD
S 45°E 27.93' SET CAPPED 3/8" REROD
S 45°W 17.89' SET CAPPED 3/8" REROD
N 45°W 22.19' SET CAPPED 3/8" REROD
S 30°E 39.38' CENTERLINE STOP SIGN POST
N 20°W 67.91' SET NAIL W-T TAG E FACE 24" MAPLE (NW 66.75' TO TAG IN 24" TREE (R)) (TAG NOT FOUND)
N 30°E 44.21' SET NAIL W-T TAG S FACE 4" SQUARE WOOD POST

Signed by Paul M. Ciosek

Date 12/22/97

Surveyor's Michigan License No. 25835

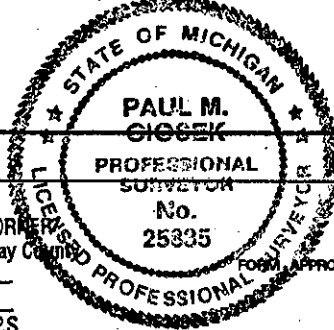

FIELD BOOK , PAGE 6

APPROVED LAND CORNER
P.A. 345 OF 1990 - Bay County
Date 31 July 97
MJM
Michael MacDonald P.S.
County Representative

APPROVED BY MICHIGAN STATE BOARD OF PROFESSIONAL SURVEYORS, JAN. 28, 197

004 70

REVISED MAY 14, 197
REVISED JAN., 198
REVISED OCT., 199