

**BAY COUNTY REMONUMENTATION
LAND CORNER RECORDATION CERTIFICATE
Filing Requirement of Act 74, Mich. P.A. 1970**

Michigan State Board of Professional Surveyors
 REGISTER OF DEEDS
 BAY COUNTY, MICHIGAN

DEC 30 3 55 PM '97

RECORDED

For corners in

<u>BAY COUNTY</u> (County)	Located In:	Corner Code #
1. Public Land Survey	T <u>16N</u> R <u>3E</u>	<u>K-4</u>
	T _____ R _____	_____
	T _____ R _____	_____
	T _____ R _____	_____
2. Property Controlling in Section	S _____ T _____ R _____	_____
	S _____ T _____ R _____	_____
3. Miscellaneous Property in Sec.	S _____ T _____ R _____	_____
	S _____ T _____ R _____	_____

Register of Deeds Stamp & File Number

4. Lot No. _____, Recorded Plat _____

5. Private Claims _____

1	A	B	C	D	E	F	G	H	I	J	K	L	M
2		6		5		4		3		2		1	
3													
4		7		8		9		10		11	●	12	
5													
6		18		17		16		15		14		13	
7													
8		19		20		21		22		23		24	
9													
10		30		29		28		27		26		25	
11													
12		31		32		33		34		35		36	
13													

I, Paul M. Ciosek, in a field survey on JULY 29, 1997 do hereby state that under requirements of P.A. 74, Michigan P.A. of 1970, the corner points mentioned in lines 1 and 2 above were in conformance with regulations and rules therefore as required in the current manual of survey instructions of the United States Department of the Interior, Bureau of Land Management or by a decree of a Court of Law and /or that the corner points mentioned in lines 3, 4 and 5 above were in conformance with the rules of the Michigan Board of Land Surveyors or by a Decree of a Court of Law; established, re-established, monumented, recovered, found as expressed below:

NOTE: Not more than 2 corners, all in the same town and range, may be recorded on this certificate.

A. Description of original monument and accessories and/or subsequent restoration:

- K-4
- POST SET BY J. MULLETT D.S., RESURVEY, JUNE 1846
W. PINE 16° N 45°W 1.3 CHAINS
MAPLE 10° S 32°E 1.12 CHAINS
 - LCRC, L. 2, P. 477, MARTIN, (9/1977) FOUND DOUBLE BLADED AXE HEAD ON END ABOUT 1' BELOW GRADE AND LARGE POINTED STONE JUST BELOW AXE HEAD. SET 3/4" PIPE OVER STONE, W 39.2' TO FACE 14" MAPLE, N 70°W 93.10' TO SE COR. FOUNDATION OF HOUSE
 - SURVEY, L. 837, P. 290, WADE TRIM FIELD NOTES ELS 2020.11, 10/1/80, FND 3/4" PIPE

B. Description of corner evidence found and/or method applied in restoring or reestablishing corner:

K-4
SEARCHED THE APPARENT LOCATION OF THE CORNER AND FOUND A 3/4" PIPE OF RECORD 2" BELOW THE SURFACE OF THE ROAD. PULLED THE PIPE AND EXCAVATED AND FOUND AN AXE HEAD 0.1' NORTH OF THE PIPE. ACCEPTED THE 3/4" PIPE AS THE BEST AVAILABLE EVIDENCE OF THE POSITION OF THE ORIGINAL CORNER.


C. Description of monument for corner and accessories established to perpetuate locating the position of the corner:

K-4
REPLACED THE FOUND 3/4" PIPE WITH A 5/8" X 24" REROD WITH A BAY COUNTY REMONUMENTATION CAP WITH 3/16" DRILL HOLE IN MONUMENT BOX.
N 45°E 14.81' SET CAPPED 3/8" REROD
S 30°E 15.65' SET CAPPED 3/8" REROD
S 45°W 17.74' SET CAPPED 3/8" REROD
N 30°W 14.40' SET CAPPED 3/8" REROD
WEST 39.79' SET NAIL AND TAG IN SOUTH FACE 18" OAK (W. 39.2 FACE 14" MAPLE) (R)
N 60°W 92.97' SW CORNER OF HSE # 2245 (93.1) (R)
N 55°W 83.42' CENTERLINE OF WELL HEAD

Signed by Paul M. Ciosek

Date 12/22/97

Surveyor's Michigan License No. 25835

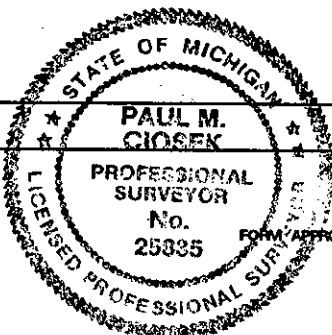

FIELD BOOK , PAGE 20

APPROVED LAND CORNER
P.A. 345 OF 1990 - Bay County
Date 21 Aug 97
MJM
Michael MacDonald P.S.

FORM APPROVED BY MICHIGAN STATE BOARD OF PROFESSIONAL SURVEYORS, JAN. 28, 197
REVISED MAY 14, 197
REVISED JAN., 198
REVISED OCT., 199

004 71