

**BAY COUNTY REMONUMENTATION  
LAND CORNER RECORDATION CERTIFICATE  
Filing Requirement of Act 74, Mich. P.A. 1970**

For corners in

<u>BAY COUNTY</u> (County)	Located In:	Corner Code #
1. Public Land Survey	T16N R3E	K-5
	T ___ R ___	_____
	T ___ R ___	_____
	T ___ R ___	_____
2. Property Controlling in Section	S ___ T ___ R ___	_____
	S ___ T ___ R ___	_____
3. Miscellaneous Property in Sec.	S ___ T ___ R ___	_____
	S ___ T ___ R ___	_____

Dec 30 3 39 PM '97  
 Register of Deeds  
 BAY COUNTY, MICHIGAN

RECORDED

Register of Deeds Stamp & File Number

4. Lot No. \_\_\_\_\_, Recorded Plat \_\_\_\_\_

5. Private Claims \_\_\_\_\_

I, Paul M. Ciosek, in a field survey on JULY 29, 1997 do hereby state that under requirements of P.A. 74, Michigan P.A. of 1970, the corner points mentioned in lines 1 and 2 above were in conformance with regulations and rules therefore as required in the current manual of survey instructions of the United States Department of the Interior, Bureau of Land Management or by a decree of a Court of Law and /or that the corner points mentioned in lines 3, 4 and 5 above were in conformance with the rules of the Michigan Board of Land Surveyors or by a Decree of a Court of Law; established, re-established, monumented, recovered, found as expressed below:

	A	B	C	D	E	F	G	H	I	J	K	L	M
1													
2	6		5		4		3		2		1		
3													
4	7		8		9		10		11		12		
5													
6	18		17		16		15		14		13		
7													
8	19		20		21		22		23		24		
9													
10	30		29		28		27		26		25		
11													
12	31		32		33		34		35		36		
13													

**NOTE:** Not more than 2 corners, all in the same town and range, may be recorded on this certificate.

**A. Description of original monument and accessories and/or subsequent restoration:**

- K-5
- POST SET BY J. MULLETT D.S., JUNE 24, 1846  
HEMLOCK 12" S 42°W 42 LINKS  
HEMLOCK 8" N 30°W 33 LINKS
  - SURVEY, BY EDMANDS, UNRECORDED, JOB #5205, 1968, NO CALL
  - SURVEY, L. 803, P. 341, MCGINNIS, (11/16/76) 3/8" REROD
  - SURVEY, L. 897, P. 290, MCGINNIS, (10/10/80) FIELD NOTES, P.K. NAIL OVER GOOD REACTION
  - SURVEY, L. 1137, P. 996, LEDY, (1/13/90), FND RR SPIKE


**B. Description of corner evidence found and/or method applied in restoring or reestablishing corner:**

K-5  
SEARCHED THE APPARENT LOCATION OF THE CORNER AND FOUND A RAIL ROAD SPIKE AT THE SURFACE OF THE ROAD. EXCAVATED THE AREA AND FOUND ANOTHER RAIL ROAD SPIKE 0.6' BELOW THE SURFACE AND 0.25' NORTH, 0.4' WEST OF THE RAILROAD SPIKE AT THE SURFACE. ACCEPTED THE RAILROAD SPIKE 0.6' BELOW THE SURFACE AS THE BEST AVAILABLE EVIDENCE OF THE POSITION OF THE ORIGINAL CORNER.

**C. Description of monument for corner and accessories established to perpetuate locating the position of the corner:**

K-5  
REPLACED THE LOWER FOUND RAILROAD SPIKE WITH A 5/8" X 24" REROD WITH A BAY COUNTY REMONUMENTATION CAP WITH 3/16" DRILL HOLE IN MONUMENT BOX.  
S 20°E 34.43' CENTERLINE OF STOP SIGN POST  
S 45°W 29.84' SET CAPPED 3/8" REROD  
S 40°E 24.63' SET CAPPED 3/8" REROD  
N 40°E 32.26' SET CAPPED 3/8" REROD  
N 30°W 25.51' SET CAPPED 3/8" REROD  
N 20°W 31.54' CENTERLINE OF STOP SIGN POST (N 30°W 31.95 TO STOP SIGN (R))  
S 45°E 127.18' SET N/T IN NE FACE U. POLE

Signed by Paul M. Ciosek  
Surveyor's Michigan License No. 25835

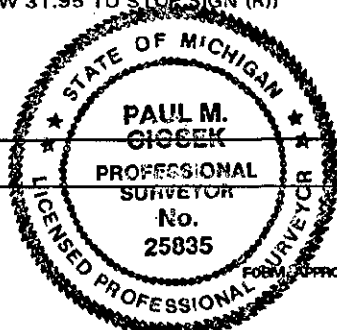

Date 12/22/97

FILED BOOK , PAGE 17

APPROVED LAND CORNER  
P.A. 345 OF 1990 - Bay County  
Date 11 Sept 97  
MJM  
Michael MacDonald P.S.

FORM APPROVED BY MICHIGAN STATE BOARD OF PROFESSIONAL SURVEYORS, JAN. 28, 197  
REVISED MAY 14, 197  
REVISED JAN., 198  
REVISED OCT., 199

004 72