

**BAY COUNTY REMONUMENTATION
LAND CORNER RECORDATION CERTIFICATE
Filing Requirement of Act 74, Mich. P.A. 1970**

For corners in

BAY COUNTY Located In: Corner Code #
(County)

1. Public Land Survey T16N R3E K-6
T R
T R
T R

2. Property Controlling S T R
in Section S T R
3. Miscellaneous S T R
Property in Sec. S T R

Register of Deeds
 BAY COUNTY, MICHIGAN

DEC 30 3 39 PM '97

RECORDED

Register of Deeds Stamp & File Number

4. Lot No. _____, Recorded Plat _____

5. Private Claims _____

I, Paul M. Ciosek, in a field survey on JULY 29, 1997 do hereby state that under requirements of P.A. 74, Michigan P.A. of 1970, the corner points mentioned in lines 1 and 2 above were in conformance with regulations and rules therefore as required in the current manual of survey instructions of the United States Department of the Interior, Bureau of Land Management or by a decree of a Court of Law and /or that the corner points mentioned in lines 3, 4 and 5 above were in conformance with the rules of the Michigan Board of Land Surveyors or by a Decree of a Court of Law; established, re-established, monumented, recovered, found as expressed below:

	A	B	C	D	E	F	G	H	I	J	K	L	M
1													
2	6		5		4		3		2		1		
3													
4	7		8		9		10		11		12		
5													
6	18		17		16		15		14		13		
7													
8	19		20		21		22		23		24		
9													
10	30		29		28		27		26		25		
11													
12	31		32		33		34		35		36		
13													

NOTE: Not more than 2 corners, all in the same town and range, may be recorded on this certificate.

A. Description of original monument and accessories and/or subsequent restoration:

- K-6
- POST SET BY J. MULLETT D.S., RESURVEY JUNE 1846
HEMLOCK 7" S 28°W 15 LINKS
HEMLOCK 6" S 88°E 24 LINKS
 - EDMANDS SURVEY (11/76) LIBER 803, PAGE 341
FOUND 3/8" IRON
N10°E 128.00 TO FACE OF TELEPHONE POLE - GONE
E 39.5 FACE OF 15" ASH - 39.30 TO STUMP
SE 56.0 FACE TO TELEPHONE POLE (56.05 MEASURED)
 - LIBER 1137, PAGE 996, LEDY (1190)
FOUND 1/4" ROD
21.90 TO FACE - POST IS LEANING
E 21.32 FENCE POST
S 45E 55.94 TO FACE OF POWER POLE (56/05 MEASURED)
W 33.0 IRON WITH CAP (32.92 MEASURED - 1/2" REROD)
N 30°W 92.00 SE CORNER TELEPHOEN RISER (92.20 MEASURED)

B. Description of corner evidence found and/or method applied in restoring or reestablishing corner:


K-6
SEARCHED THE APPARENT LOCATION OF THE CORNER AND FOUND A 3/4" PIPE, VERIFIED LOCATION FROM WITNESSES FROM ABOVE LIBER AND PAGES. EXCAVATED THE AREA AND FOUND NO OTHER OBJECTS. ACCEPTED THE 3/4" PIPE AS THE BEST AVAILABLE EVIDENCE OF THE POSITION OF THE ORIGINAL CORNER.

C. Description of monument for corner and accessories established to perpetuate locating the position of the corner:

- K-6
REPLACED 3/4" PIPE WITH A 5/8" X 24" REROD WITH A BAY COUNTY REMONUMENTATION CAP WITH 3/16" DRILL HOLE IN MONUMENT BOX.
N50°E 16.25' SET CAPPED 3/8" IRON
EAST 22.05' NAIL/TAG NORTH FACE RR TIE
S45°E 17.32' SET CAPPED 3/8" IRON
S15°W 58.85' NAIL/TAG EAST FACE 8" ASPEN
S35°W 17.13' SET CAPPED 3/8" IRON
S50°W 56.37' SET NAIL/TAG IN NE FACE OF UTILITY POLE
N40°W 14.67' SET CAPPED 3/8" IRON
N 10°W 92.20' (92.00' R.) SE CORNER OF TELEPHONE RISER

Signed by Paul M. Ciosek
Surveyor's Michigan License No. 25835

Date 12/22/97

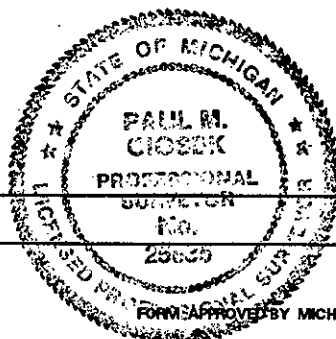

FIELDBOOK # _____, PAGE 14

APPROVED LAND CORNER
P.A. 345 OF 1990 - Bay County
Date 21 Aug 97
MTM
Michael MacDonald P.S.
County Representative