

**BAY COUNTY REMONUMENTATION
LAND CORNER RECORDATION CERTIFICATE
Filing Requirement of Act 74, Mich. P.A. 1970**

For corners in

<u>BAY COUNTY</u> (County)	Located in:	Corner Code #
1. Public Land Survey	T <u>16N</u> R <u>3E</u>	<u>K-8</u>
	T _____ R _____	_____
	T _____ R _____	_____
	T _____ R _____	_____
2. Property Controlling in Section	S _____ T _____ R _____	_____
	S _____ T _____ R _____	_____
3. Miscellaneous Property in Sec.	S _____ T _____ R _____	_____
	S _____ T _____ R _____	_____

Dec 30 3 39 PM '97
 Register of Deeds
 BAY COUNTY, MICHIGAN

RECORDED

Register of Deeds Stamp & File Number

4. Lot No. _____, Recorded Plat _____

5. Private Claims _____

I, Paul M. Ciosek, in a field survey on JUNE 19, 19 97 do hereby state that under requirements of P.A. 74, Michigan P.A. of 1970, the corner points mentioned in lines 1 and 2 above were in conformance with regulations and rules therefore as required in the current manual of survey instructions of the United States Department of the Interior, Bureau of Land Management or by a decree of a Court of Law and /or that the corner points mentioned in lines 3, 4 and 5 above were in conformance with the rules of the Michigan Board of Land Surveyors or by a Decree of a Court of Law; established, re-established, monumented, recovered, found as expressed below:

A	B	C	D	E	F	G	H	I	J	K	L	M
1												
2	6		5		4		3		2		1	
3												
4	7		8		9		10		11		12	
5												
6	18		17		16		15		14		13	
7												
8	19		20		21		22		23		24	
9												
10	30		29		28		27		26		25	
11												
12	31		32		33		34		35		36	
13												

NOTE: Not more than 2 corners, all in the same town and range, may be recorded on this certificate.

A. Description of original monument and accessories and/or subsequent restoration:

- K-8
1. SET POST, J. MULLETT D.S., RESURVEY 1846
W. PINE 14" N 45°W 9 LINKS
MAPLE 10" S 63°E 7 LINKS
 2. LCRC, L.1, P.567,568, SCHAFER (5/4/73), FND STONE WITH STONES AROUND, SET 3/4" PIPE, WEST-TAG IN CORNER FENCE POST - 25.55' N 20°W-TAG IN 15" COTTONWOOD - 91.0', EAST - TAG IN CORNER FENCE POST - 24.05
 3. SURVEY, L. 900, P. 669, MACDONALD, (3/2/81) FND IRON, N 20°W 89.0' TO FACE 30" TREE, W 24.5' TO FACE OF SQUARE WOOD POST
 4. SURVEY, L. 951, P. 418, MCGINNIS, (10/21/83) FND 3/4". N 20°W 89.0' TO FACE 30" TREE, W 24.5' TO FACE OF SQUARE WOOD POST
 5. SURVEY, L. 1135, P. 274-275, BURGIN, (11/20/89) SET "T"-IRON WITH CAP IN RECORD POSITION

B. Description of corner evidence found and/or method applied in restoring or reestablishing corner:


K-8
SEARCHED THE APPARENT LOCATION OF THE CORNER AND FOUND THE "T" IRON (MENTIONED IN L. 1135, P. 275) BELOW THE ROAD SURFACE. FOUND THREE LARGE ROCKS WITH ONE IN THE CENTER AND SIX SMALLER STONES AROUND THE PILE (PER LCRC L. 1, P. 367-368) 12" BELOW THE SURFACE OF THE ROAD. AT 16" HIT CLAY. FOUND NO OTHER OBJECTS IN THE AREA. T IRON ACCEPTED AS THE BEST AVAILABLE EVIDENCE OF THE POSITION OF THE ORIGINAL CORNER.

C. Description of monument for corner and accessories established to perpetuate locating the position of the corner:

K-8
REPLACED T IRON OF RECORD WITH A 5/8" X 24" REROD WITH A BAY COUNTY REMONUMENTATION CAP WITH 3/16" DRILL HOLE IN MONUMENT BOX.
N 45° E 23.54' SET CAPPED 3/8" IRON
S 45° E 29.80' SET REMON TAG IN SOUTHEAST FACE 5" ELM
S 87° E 43.92' SET REMON TAG IN NORTH FACE 9" POPLAR
S 45° W 44.45' SET REMON TAG NORTHEAST FACE 9" POPLAR
N 25° W 75.14' SET REMON TAG SOUTHWEST FACE 6" ASPEN
N 45° W 17.55' SET CAPPED 3/8" IRON
WEST 25.05' SET REMON TAG NORTH FACE SQUARE WOOD POST

Signed by Paul M. Ciosek
Surveyor's Michigan License No. 25835

Date 12/22/97

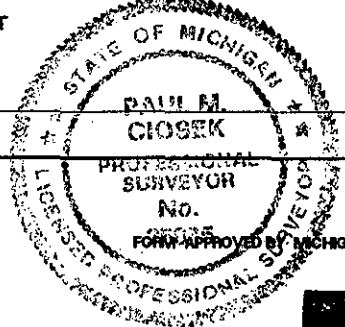

FIELD BOOK , PAGE 74

APPROVED LAND CORNER
P.A. 345 OF 1990 - Bay County
Date 27 June 97
MJM
Michael MacDonald P.S.
County Representative