

**BAY COUNTY REMONUMENTATION  
LAND CORNER RECORDATION CERTIFICATE  
Filing Requirement of Act 74, Mich. P.A. 1970**

Register of Deeds  
 BAY COUNTY, MICHIGAN

DEC 30 3 39 PM '97

RECORDED

For corners in

<u>BAY COUNTY</u> (County)	Located In:	Corner Code #	
1. Public Land Survey	T <u>16N</u> R <u>3E</u>	<u>K-10</u>	
	T _____ R _____	_____	
	T _____ R _____	_____	
	T _____ R _____	_____	
2. Property Controlling in Section	S _____ T _____ R _____	_____	
	S _____ T _____ R _____	_____	
3. Miscellaneous Property in Sec.	S _____ T _____ R _____	_____	
	S _____ T _____ R _____	_____	

Register of Deeds Stamp & File Number

4. Lot No. \_\_\_\_\_, Recorded Plat \_\_\_\_\_

5. Private Claims \_\_\_\_\_

I, Paul M. Ciosek, in a field survey on JUNE 18, 1997 do hereby state that under requirements of P.A. 74, Michigan P.A. of 1970, the corner points mentioned in lines 1 and 2 above were in conformance with regulations and rules therefore as required in the current manual of survey instructions of the United States Department of the Interior, Bureau of Land Management or by a decree of a Court of Law and /or that the corner points mentioned in lines 3, 4 and 5 above were in conformance with the rules of the Michigan Board of Land Surveyors or by a Decree of a Court of Law; established, re-established, monumented, recovered, found as expressed below:

**NOTE: Not more than 2 corners, all in the same town and range, may be recorded on this certificate.**

	A	B	C	D	E	F	G	H	I	J	K	L	M
1													
2	6		5		4		3		2		1		
3													
4	7		8		9		10		11		12		
5													
6	18		17		16		15		14		13		
7													
8	19		20		21		22		23		24		
9													
10	30		29		28		27		26		25		
11													
12	31		32		33		34		35		36		
13													

A. Description of original monument and accessories and/or subsequent restoration:

- K-10
- SET POST J. MULLETT D.S. RESURVEY JUNE 1846  
MAPLE 8" S 85°W 59 LINKS  
B. ASH 8" N 75°E 28 LINKS
  - LCRC L. 2, P. 35, SCHAFFER, (11/1/73) SET 3/4" PIPE AND CAP BY DOUBLING DISTANCE FROM NORTH 1/8 CORNER AND K-9
  - SURVEY, L. 805, P. 198, MCGINNIS, (12/10/76) FND 3/4" PIPE ON CENTERLINE OF DRAIN TO THE WEST AND NORTH BANK LINE TO EAST
  - LCRC L. 2, P. 247, MCGINNIS, (6/21/77) FND 3/4" PIPE
  - SURVEY, UNRECORDED, SEDGMAN PS 18664, (11/7/81) FND 3/4" PIPE WITH RLS CAP
  - SURVEY, L. 1334, P. 802, MCGINNIS, (6/7/94) FND 3/4" PIPE ON CENTERLINE OF DRAIN TO THE WEST

B. Description of corner evidence found and/or method applied in restoring or reestablishing corner:

K-10  
SEARCHED THE APPARENT LOCATION OF THE CORNER AND FOUND 3/4" PIPE OF RECORD 3 1/2" BELOW GRAVEL SURFACE. FOUND WOOD POST NEXT TO PIPE AT 4" BELOW GRAVEL SURFACE. ACCEPTED THE FOUND 3/4" PIPE AS THE BEST AVAILABLE EVIDENCE OF THE POSITION OF THE ORIGINAL CORNER.

C. Description of monument for corner and accessories established to perpetuate locating the position of the corner:


K-10  
REPLACED THE FOUND 3/4" PIPE WITH A 5/8" X 24" REROD WITH A BAY COUNTY REMONUMENTATION CAP WITH 3/16" DRILL HOLE IN MONUMENT BOX.  
N 45° E 29.06 SET 3/8" REROD WITH P.S. 25835  
S 45° E 24.84 SET 3/8" REROD WITH P.S. 25835  
S 45° W 18.50 SET 3/8" REROD WITH P.S. 25835  
S 45° W 47.45 SET REMON TAG IN SOUTHWEST FACE OF FENCE POST  
S 55° W 33.81 SET REMON TAG IN NORTHWEST FACE OF FENCE POST  
S 65° W 54.63 SET REMON TAG IN NORTH FACE OF FENCE POST  
N 45° W 15.53 SET 3/8" REROD WITH P.S. 25835

Signed by Paul M. Ciosek

Date 12/22/97

Surveyor's Michigan License No. 25835

FIELD BOOK , PAGE 4

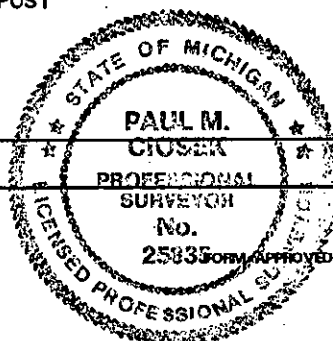

APPROVED LAND CORNER  
P.A. 345 OF 1990 - Bay County  
Date 27 June 97  
MJM  
Michael MacDonald P.S.  
County Representative

FORM APPROVED BY MICHIGAN STATE BOARD OF PROFESSIONAL SURVEYORS, JAN. 28, 197  
REVISED MAY 14, 197  
REVISED JAN., 198  
REVISED OCT., 199

004 77