

**BAY COUNTY REMONUMENTATION  
LAND CORNER RECORDATION CERTIFICATE  
Filing Requirement of Act 74, Mich. P.A. 1970**

For corners in

<u>BAY COUNTY</u> (County)	Located in:	Corner Code #
1. Public Land Survey	<u>T16N R3E</u>	<u>L-1</u>
	T ___ R ___	_____
	T ___ R ___	_____
	T ___ R ___	_____
2. Property Controlling in Section	S ___ T ___ R ___	_____
	S ___ T ___ R ___	_____
3. Miscellaneous Property in Sec.	S ___ T ___ R ___	_____
	S ___ T ___ R ___	_____

*Michael MacDonald*  
 REGISTER OF DEEDS  
 BAY COUNTY, MICHIGAN  
 JAN 6 10 10 AM '98

RECORDED

Register of Deeds Stamp & File Number

4. Lot No. \_\_\_\_\_, Recorded Plat \_\_\_\_\_

5. Private Claims \_\_\_\_\_

I, Paul M. Ciosek, in a field survey on JULY 29, 1997 do hereby state that under requirements of P.A. 74, Michigan P.A. of 1970, the corner points mentioned in lines 1 and 2 above were in conformance with regulations and rules therefore as required in the current manual of survey instructions of the United States Department of the Interior, Bureau of Land Management or by a decree of a Court of Law and /or that the corner points mentioned in lines 3, 4 and 5 above were in conformance with the rules of the Michigan Board of Land Surveyors or by a Decree of a Court of Law; established, re-established, monumented, recovered, found as expressed below:

A	B	C	D	E	F	G	H	I	J	K	L	M
1												
2	6		5		4		3		2		1	
3												
4	7		8		9		10		11		12	
5												
6	18		17		16		15		14		13	
7												
8	19		20		21		22		23		24	
9												
10	30		29		28		27		26		25	
11												
12	31		32		33		34		35		36	
13												

**NOTE: Not more than 2 corners, all in the same town and range, may be recorded on this certificate.**

A. Description of original monument and accessories and/or subsequent restoration:

- L-1  
 1. POST SET BY ROBERT CLARK JR. D.S. JUNE 1831  
 BLACK ASH 8" N 59°E 27 LINKS  
 ELM 18" N 55°W 48 LINKS
3. SURVEY L. 822, P. 533, MCGINNIS, (7/12/77) DISTANCE CALL FROM L-13, T 17N, R3E TO L-1, T16N, R3E, 7.92' (8.01' M)
4. SURVEY, L. 922, P. 327, LEDY, (MAY 1982) FOUND 3/4" PIPE  
 ESE, 168.00' ( 167.95' M) TO NAIL IN POWER POLE  
 EAST 7.98' (8.01' M) TO S1/4 CORNER OF SECTION 36, T17N, R3E
5. LCRC, L. 2, P. 549, LEDY, (5/20/82) FND 3/4" PIPE  
 ESE, 168.00' ( 167.95' M) TO NAIL IN POWER POLE  
 EAST 7.98' (8.01' M) TO S1/4 CORNER OF SECTION 36, T17N, R3E
6. SURVEY L. 822, P. 533, MCGINNIS, (7/12/77) DISTANCE CALL FROM L-13, T 17N, R3E TO L-1, T16N, R3E, 7.92' (8.01' M)

B. Description of corner evidence found and/or method applied in restoring or reestablishing corner:

L-1 SEARCHED THE APPARENT LOCATION OF THE CORNER AND FOUND A 3/4" PIPE 2" BELOW THE SURFACE OF THE ROAD, 8.01' WEST OF L-13, T17N, R3E. FOUND NO OTHER OBJECTS IN THE AREA. SET CORNER 7.92' WEST OF S1/4 CORNER SECTION 36, T17N, R3E.


C. Description of monument for corner and accessories established to perpetuate locating the position of the corner:

L-1 REMOVED FOUND 3/4" PIPE  
 SET 5/8" X 24" REROD WITH BAY COUNTY REMONUMENTATION CAP WITH 3/16" DRILL HOLE IN MONUMENT BOX, 7.92' WEST OF L-13, T17N, R3E, PER PREVIOUSLY RECORDED LOCATION  
 SOUTH 71.90' SET NAIL AND TAG IN EAST FACE UTILITY POLE  
 N 45°E 17.03' SET CAPPED 3/8" REROD  
 EAST 7.92' FND 3/8" REROD S1/4 CORNER SECTION 36, T17N, R3E (THIS WAS REPLACED WITH A BAY COUNTY REMONUMENTATION CAP)  
 S 45°E 12.33' SET CAPPED 3/8" REROD  
 SOUTH 71.90' SET N/T EAST FACE U.P.  
 S 45°W 13.43' SET CAPPED 3.8" REROD  
 N 45°W 17.62' SET CAPPED 3.8" REROD

Signed by Paul M. Ciosek

Surveyor's Michigan License No. 25835

FIELDBOOK # \_\_\_\_\_, PAGE 21

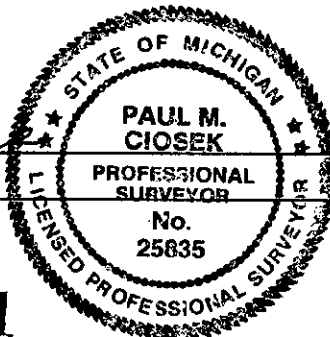

Date 12/31/97

004 111

APPROVED LAND CORNER  
 P.A. 345 OF 1990 - Bay County  
 Date: 12 Oct 97  
HJM  
 Michael MacDonald P.S.