

**BAY COUNTY REMONUMENTATION
LAND CORNER RECORDATION CERTIFICATE
Filing Requirement of Act 74, Mich. P.A. 1970**

For corners in

<u>BAY COUNTY</u> (County)	Located In:	Corner Code #
1. Public Land Survey	<u>T16N R3E</u>	<u>L-5</u>
	T <u> </u> R <u> </u>	<u> </u>
	T <u> </u> R <u> </u>	<u> </u>
	T <u> </u> R <u> </u>	<u> </u>
2. Property Controlling in Section	S <u> </u> T <u> </u> R <u> </u>	<u> </u>
	S <u> </u> T <u> </u> R <u> </u>	<u> </u>
3. Miscellaneous Property in Sec.	S <u> </u> T <u> </u> R <u> </u>	<u> </u>
	S <u> </u> T <u> </u> R <u> </u>	<u> </u>

REGISTER OF DEEDS
 BAY COUNTY, MICHIGAN

DEC 30 3 39 PM '97

RECORDED

Register of Deeds Stamp & File Number

4. Lot No. _____, Recorded Plat _____
 5. Private Claims _____

I, Paul M. Ciosek, in a field survey on AUGUST 1, 19 97 do hereby state that under requirements of P.A. 74, Michigan P.A. of 1970, the corner points mentioned in lines 1 and 2 above were in conformance with regulations and rules therefore as required in the current manual of survey instructions of the United States Department of the Interior, Bureau of Land Management or by a decree of a Court of Law and/or that the corner points mentioned in lines 3, 4 and 5 above were in conformance with the rules of the Michigan Board of Land Surveyors or by a Decree of a Court of Law; established, re-established, monumented, recovered, found as expressed below:

	A	B	C	D	E	F	G	H	I	J	K	L	M
1													
2	6		5		4		3		2				
3													
4	7		8		9		10		11		12		
5													
6	18		17		16		15		14		13		
7													
8	19		20		21		22		23		24		
9													
10	30		29		28		27		26		25		
11													
12	31		32		33		34		35		36		
13													

NOTE: Not more than 2 corners, all in the same town and range, may be recorded on this certificate.

A. Description of original monument and accessories and/or subsequent restoration:

- L-5
 1. POST SET BY J. MULLETT D.S. 1846
 LYNN 10" N 9"W 36 LINKS
 SUGAR 10" S 9"W 42 LINKS
2. SURVEY, L. 763, P. 417, MCGINNIS, (6/17/75) FOUND 3/4" PIPE
3. SURVEY, L. 774, P. 260, MCGINNIS, (11/24/75) FND 1" BAR
4. LCRC, L. 02, P. 387, MacDONALD, (1/16/76) FOUND 3/4" PIPE
5. SURVEY, L. 812, P. 209, MCGINNIS, (3/12/77) FND 3/4" PIPE
6. SURVEY, L. 921, P. 588, MacDONALD, (1/19/82) FOUND 3/8" IRON
7. SURVEY, L. 1215, P. 262, MCGINNIS, (12/23/91) NO CALL

B. Description of corner evidence found and/or method applied in restoring or reestablishing corner:


L-5 SEARCHED THE APPARENT LOCATION OF THE CORNER AND FOUND A 3/8" REROD AT THE ASPHALT ROAD SURFACE. EXCAVATED THE AREA AND FOUND 3" OF ASPHALT AND 9" OF SAND. HIT OLD ROAD BED AT 1.1' AND FOUND THE 3/4" PIPE AND THREE OTHER METAL OBJECTS LISTED BELOW AND THERE LOCATION RELATIVE TO THE 3/4" PIPE:

- 1 1/2"x1/2" METAL BAR, 0.10' W, 0.18' S
- 3/8" REROD, 0.1' WEST AND 0.08' NORTH
- 1 1/2"x1" BAR, 0.2' WEST, 0.23' NORTH
- 1"x1/2" BAR, 0.02' WEST, 0.20' NORTH

ACCEPTED THE 3/4" PIPE AS THE BEST AVAILABLE EVIDENCE OF THE POSITION OF THE ORIGINAL CORNER.

C. Description of monument for corner and accessories established to perpetuate locating the position of the corner:


L-5 REPLACED FOUND 3/4" PIPE WITH 5/8" X 24" REROD WITH BAY COUNTY REMONUMENTATION CAP WITH 3/16" DRILL HOLE IN MONUMENT BOX.
 N 45°E 29.98' SET CAPPED 3/8" REROD
 S 35°E 27.92' SET CAPPED 3/8" REROD
 S 40°W 29.59' SET CAPPED 3/8" REROD
 N 35°W 25.62' SET CAPPED 3/8" REROD
 S 30°E 44.64' FOUND PK IN WEST FACE 4"x4" WOOD POST
 S 10°W 125.55' SET NAIL/TAG IN EAST FACE UTILITY
 S 20°E 39.23' TO NORTH FACE STOP SIGN POST

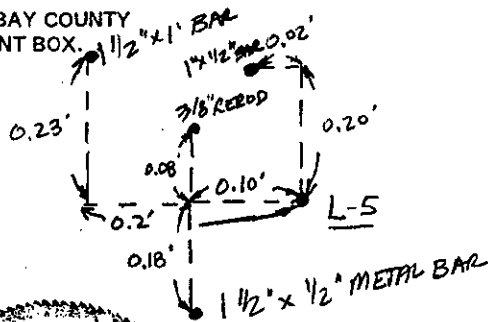

Signed by Paul M. Ciosek

Date 12/22/97

Surveyor's Michigan License No. 25835

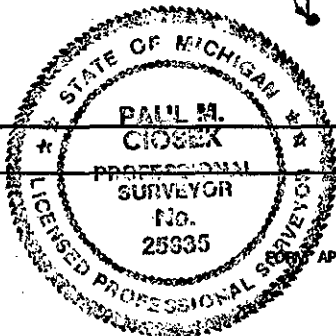

FIELDBOOK # _____, PAGE 8, 22

APPROVED LAND CORNER
 P.A. 345 OF 1990 - Bay County
 Date 21 Aug 97
MJM
 Michael MacDonald P.S.

APPROVED BY MICHIGAN STATE BOARD OF PROFESSIONAL SURVEYORS, JAN. 28, 1971
 REVISED MAY 14, 1975
 REVISED JAN., 199
 REVISED OCT., 199

004

79