

**BAY COUNTY REMONUMENTATION
LAND CORNER RECORDATION CERTIFICATE
Filing Requirement of Act 74, Mich. P.A. 1970**

Restoration of Corner Monument
REGISTER OF DEEDS
BAY COUNTY, MICHIGAN

DEC 30 3 39 PM '97

RECORDED

For corners in

<u>BAY COUNTY</u> (County)	Located In:	Corner Code #
1. Public Land Survey	T <u>16N</u> R <u>3E</u>	<u>L-7</u>
	T _____ R _____	_____
	T _____ R _____	_____
	T _____ R _____	_____
2. Property Controlling in Section	S _____ T _____ R _____	_____
	S _____ T _____ R _____	_____
3. Miscellaneous Property in Sec.	S _____ T _____ R _____	_____
	S _____ T _____ R _____	_____

Register of Deeds Stamp & File Number

4. Lot No. _____, Recorded Plat _____

5. Private Claims _____

I, Paul M. Ciosek, in a field survey on AUGUST 29, 19 97 do hereby state that under requirements of P.A. 74, Michigan P.A. of 1970, the corner points mentioned in lines 1 and 2 above were in conformance with regulations and rules therefore as required in the current manual of survey instructions of the United States Department of the Interior, Bureau of Land Management or by a decree of a Court of Law and /or that the corner points mentioned in lines 3, 4 and 5 above were in conformance with the rules of the Michigan Board of Land Surveyors or by a Decree of a Court of Law; established, re-established, monumented, recovered, found as expressed below:

1	A	B	C	D	E	F	G	H	I	J	K	L	M
2		6		5		4		3		2		1	
3													
4		7		8		9		10		11		12	
5													
6		18		17		16		15		14		13	
7													
8		19		20		21		22		23		24	
9													
10		30		29		28		27		26		25	
11													
12		31		32		33		34		35		36	
13													

NOTE: Not more than 2 corners, all in the same town and range, may be recorded on this certificate.

A. Description of original monument and accessories and/or subsequent restoration:

- L-7
- 1. POST SET BY J. MULLETT D.S. 1846
BIRCH 10" S 42°W 7 LINKS
BIRCH 8" N 35°E 30 LINKS
- 2. SURVEY, L. 803, P. 341, MCGINNIS, (11/16/76) FOUND 1/2" BAR
- 3 SURVEY, L. 1215, P. 262, MCGINNIS, (12/23/91) NO CALL


B. Description of corner evidence found and/or method applied in restoring or reestablishing corner:

L-7 SEARCHED THE APPARENT LOCATION OF THE CORNER AND FOUND A 3/8" x 18" LONG REROD JUST BELOW THE SURFACE WITH THE TOP 4" BENT. EXCAVATED THE AREA AND HIT SANDY CLAY AT 15" BELOW THE SURFACE. FOUND NO OTHER OBJECTS IN THE HOLE. A 1" x 14" SOLID BAR WAS FOUND 1.4' SOUTH AND 5.30' EAST OF THE FOUND 3/8" REROD AND 8" BELOW THE GRAVEL SURFACE. NO RECORDED INFORMATION WAS FOUND USING THIS CORNER AS L-7. ACCEPTED THE 3/8" REROD AS THE BEST AVAILABLE EVIDENCE OF THE POSITION OF THE ORIGINAL CORNER.

C. Description of monument for corner and accessories established to perpetuate locating the position of the corner:

L-7 REPLACED FOUND 3/8" REROD WITH 5/8" X 24" REROD WITH BAY COUNTY REMONUMENTATION CAP WITH 3/16" DRILL HOLE IN MONUMENT BOX.
SOUTH 65.30' SET NAIL ANDTAG IN WEST FACE 12" ASH
S 50°W 72.55' SET NAIL AND TAG IN EAST FACE 18" ASH
N 70°W 153.75' SET NAIL AND TAG IN SOUTH FACE UTILITY POLE
N 70°E 130.00' SET NAIL AND TAG IN SOUTH FACE UTILITY POLE
N 45°W 34.50' TO CENTERLINE STRET SIGN POST

Signed by Paul M. Ciosek
Surveyor's Michigan License No. 25835
FIELDBOOK # _____, PAGE 13

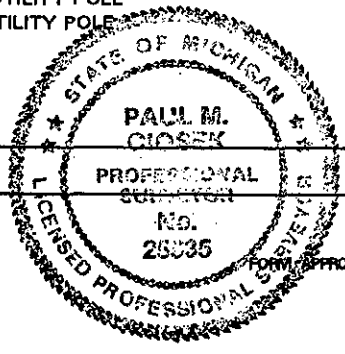

Date 12/22/97

APPROVED LAND CORNER
P.A. 345 OF 1990 - Bay County
Date 11 Sept 97
MJM
Michael MacDonald P.S.
County Representative

FORM APPROVED BY MICHIGAN STATE BOARD OF PROFESSIONAL SURVEYORS, JAN. 28, 1971
REVISED MAY 14, 1975
REVISED JAN., 198
REVISED OCT., 199