

**BAY COUNTY REMONUMENTATION
LAND CORNER RECORDATION CERTIFICATE
Filing Requirement of Act 74, Mich. P.A. 1970**

For corners in

<u>BAY COUNTY</u> (County)	Located In:	Corner Code #
1. Public Land Survey	<u>T16N R3E</u>	<u>L-9</u>
	T <u> </u> R <u> </u>	<u> </u>
	T <u> </u> R <u> </u>	<u> </u>
	T <u> </u> R <u> </u>	<u> </u>
2. Property Controlling in Section	S <u> </u> T <u> </u> R <u> </u>	<u> </u>
	S <u> </u> T <u> </u> R <u> </u>	<u> </u>
3. Miscellaneous Property in Sec.	S <u> </u> T <u> </u> R <u> </u>	<u> </u>
	S <u> </u> T <u> </u> R <u> </u>	<u> </u>

Register of Deeds
**REGISTER OF DEEDS
BAY COUNTY, MICHIGAN**

DEC 30 3 39 PM '97

RECORDED

Register of Deeds Stamp & File Number

4. Lot No. _____, Recorded Plat _____

5. Private Claims _____

I, Paul M. Ciosek, in a field survey on OCTOBER 13, 19 97 do hereby state that under requirements of P.A. 74, Michigan P.A. of 1970, the corner points mentioned in lines 1 and 2 above were in conformance with regulations and rules therefore as required in the current manual of survey instructions of the United States Department of the Interior, Bureau of Land Management or by a decree of a Court of Law and /or that the corner points mentioned in lines 3, 4 and 5 above were in conformance with the rules of the Michigan Board of Land Surveyors or by a Decree of a Court of Law; established, re-established, monumented, recovered, found as expressed below:

	A	B	C	D	E	F	G	H	I	J	K	L	M
1													
2	6		5		4		3		2		1		
3													
4	7		8		9		10		11		12		
5													
6	18		17		16		15		14		13		
7													
8	19		20		21		22		23		24		
9													
10	30		29		28		27		26		25		
11													
12	31		32		33		34		35		36		
13													

NOTE: Not more than 2 corners, all in the same town and range, may be recorded on this certificate.

A. Description of original monument and accessories and/or subsequent restoration:

- L-9
1. POST SET BY J. MULLETT D.S. 1846
BIRCH 8" S 50°W 16 LINKS
HEMLOCK 10" N 46°E 30 LINKS
 2. SURVEY, L. 657, P. 279, DELAMATER, (7/7/71) FOUND 1" PIPE
 3. SURVEY, L. 779, P. 407, MCGINNIS, (1-20-76) FOUND 1" PIPE
 4. SURVEY, L. 1257, P. 578, MCGINNIS, (12-8-92) RESET PK FROM ANGLE AND DISTANCE FROM SURVEY L. 657, P. 279

B. Description of corner evidence found and/or method applied in restoring or reestablishing corner:


L-9 SEARCHED THE APPARENT LOCATION OF THE CORNER AND FOUND A 1/2" REROD WITH PS #31603. EXCAVATED DOWN 24" BELOW THE ASPHALT ROAD SURFACE AND FOUND THE OLD GRAVEL ROAD BED AND A 1" PIPE, UNDER THE CAPPED 1/2" REROD AT THE SURFACE. ACCEPTED THE 1" PIPE AS THE BEST AVAILABLE EVIDENCE OF THE POSITION OF THE ORIGINAL CORNER.

C. Description of monument for corner and accessories established to perpetuate locating the position of the corner:

L-9 DROVE 5/8" X 24" REROD WITH BAY COUNTY REMONUMENTATION CAP WITH 3/16" DRILL HOLE INTO THE CENTER OF 1" PIPE WITH MONUMENT BOX.
NORTH 1.90' TO PHYSICAL CENTERLINE OF PREVO ROAD
N 23°W 24.97' FOUND CHISELED 'X' NORTH END CMP
S 23°W 24.28' FOUND NAIL IN TOP OF SOUTH END CMP
S 47°E 45.65' FOUND NAIL IN SW FACE 20" POPLAR
SOUTH 51.73' SET NAIL AND TAG IN WEST FACE POWER POLE
N 47°E 26.97' SET CAPPED 3/8" REROD

Signed by Paul M. Ciosek
Surveyor's Michigan License No. 25835

Date 12/22/97

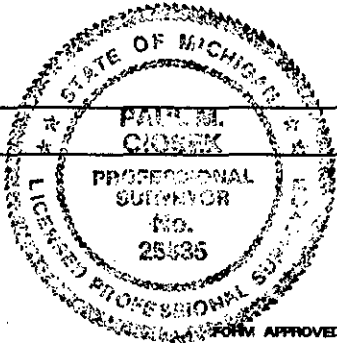

FIELDBOOK # _____, PAGE 23 & 27

APPROVED LAND CORNER
P.A. 345 OF 1990 - Bay County
Date 23 Oct 97
MJM
Michael MacDonald D.C.

FORM APPROVED BY MICHIGAN STATE BOARD OF PROFESSIONAL SURVEYORS, JAN. 28, 1971
REVISED MAY 14, 197
REVISED JAN., 198
REVISED OCT., 199

001 81