

APPROVED LAND CORNER
 P.A. 345 OF 1990 - Bay County
 Date 7/14/96
MJM
 Michael MacDonald P.S.
 County Representative

Bay County Remonumentation

LAND CORNER RECORDATION CERTIFICATE
 Filing Requirement of Act 74, Mich. P.A. 1970

SURVEY &
 REMONUMENTATION

MAY 20 1997

COMMISSION

For corners in

| Bay (County) | Located In: | Corner Code # |
|---------------------------------------|-------------|---------------|
| 1. Public Land Survey | T16N R 3E | L-11 |
| | T R | |
| | T R | |
| | T R | |
| 2. Property Controlling in Section | S T R | |
| | S T R | |
| 3. Miscellaneous Property in Sec. | S T R | |
| | S T R | |

REGISTER OF DEEDS
 BAY COUNTY, MICHIGAN
 Dec 30 4 20 PM '96
 Register of Deeds Stamp & File Number
 RECORDED

4. Lot No. _____, Recorded Plat _____
 5. Private Claims _____

I, Paul M. Ciosek, in a field survey on October 24, 1996 do hereby state that under requirements of P.A. 74, Michigan P.A. of 1970, the corner points mentioned in lines 1 and 2 above were in conformance with regulations and rules therefore as required in the current manual of survey instructions of the United States Department of the Interior, Bureau of Land Management or by a decree of a Court of Law and/or that the corner points mentioned in lines 3, 4 and 5 above were in conformance with the rules of the Michigan Board of Land Surveyors or by a Decree of a Court of Law; established, re-established, monumented, recovered, found as expressed below:

NOTE: Not more than 2 corners, all in the same town and range, may be recorded on this certificate.

| | A | B | C | D | E | F | G | H | I | J | K | L | M |
|----|---|----|---|----|---|----|---|----|---|----|---|----|---|
| 1 | | | | | | | | | | | | | |
| 2 | | 6 | | 5 | | 4 | | 3 | | 2 | | 1 | |
| 3 | | | | | | | | | | | | | |
| 4 | | 7 | | 8 | | 9 | | 10 | | 11 | | 12 | |
| 5 | | | | | | | | | | | | | |
| 6 | | 18 | | 17 | | 16 | | 15 | | 14 | | 13 | |
| 7 | | | | | | | | | | | | | |
| 8 | | 19 | | 20 | | 21 | | 22 | | 23 | | 24 | |
| 9 | | | | | | | | | | | | | |
| 10 | | 30 | | 29 | | 28 | | 27 | | 26 | | 25 | |
| 11 | | | | | | | | | | | | | |
| 12 | | 31 | | 32 | | 33 | | 34 | | 35 | | 36 | |
| 13 | | | | | | | | | | | | | |

A. Description of original monument and accessories and/or subsequent restoration:

L-11 Set post - J. Mullett, June 1846, Sub. resurvey.
 Fnd old corner - George Turner C.S. - 1908.
 Fnd iron - Recorded Survey - L. 670, P. 419; L. 759, P. 47; L. 799, P. 9; L. 856, P. 677.
 Iron - L.C.B.C. - E.L. Goss, December 1972.

B. Description of corner evidence found and/or method applied in restoring or reestablishing corner:

L-11 Fnd 1/2" x 24" rebar 0.2' deep in gravel road, fits 33' S to right-of-way Iron L. 759, P. 47, at 2' deep dug through sand and gravel road, fill into clay and at 3' deep, quit digging, no other evidence found. Accepted 1/2" Iron as best available evidence of the position of the original corner.


C. Description of monument for corner and accessories established to perpetuate locating the position of the corner:

L-11 Set Bay County Remonumentation mon (5/8" x 24" rebar with brass cap marked by 3/16" drill hole) in mon box, 6"± below gravel road surface.

S 33.02' to capped (#16040) Iron recorded survey L. 799, P. 9
 N 45° W 77.57' (77.5' - R) to PK nail in NE face of P.P.
 S 05° W 53.03' to Wade-Trim nail and tag in W face of 3" Elder.
 S 40° W 88.84' (88.4' - R) to PK nail in NW face of P.P.
 S 60° W 80.04' to Wade-Trim nail and tag in N face of 6" Ash.
 N 65° W 121.15' to top SW cor of concrete porch.
 N 20° W 108.72' (109.5' - R) to face of flag pole.
 S 45° E 55.83' to Wade-Trim nail and tag in NE face of 8" Pine.

Signed by Paul M. Ciosek
 Surveyor's Michigan License No. 25835

Date 12/23/96

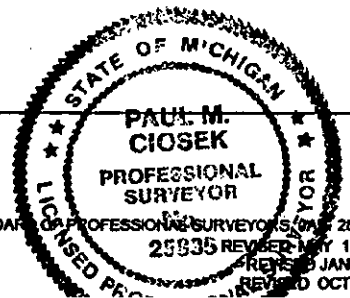

NOTE: Bearings are estimated & dist are by EDM
 NOTE: See Bay County Remon Field Book Pg. 64

FORM APPROVED BY MICHIGAN STATE BOARD OF PROFESSIONAL SURVEYORS
 003 339

STATE OF MICHIGAN BOARD OF PROFESSIONAL SURVEYORS
 25835 REVISED MAY 14, 1975
 REVISED JAN., 1983
 REVISED OCT., 1995