

**BAY COUNTY REMONUMENTATION
LAND CORNER RECORDATION CERTIFICATE
Filing Requirement of Act 74, Mich. P.A. 1970**

For corners in

<u>BAY</u> (County)	Located In:	Corner Code #
1. Public Land Survey	T <u>16N</u> R <u>3E</u>	<u>M-2</u>
	T <u>16N</u> R <u>4E</u>	<u>A-2</u>
	T _____ R _____	_____
	T _____ R _____	_____
2. Property Controlling in Section	S _____ T _____ R _____	_____
	S _____ T _____ R _____	_____
3. Miscellaneous Property in Sec.	S _____ T _____ R _____	_____
	S _____ T _____ R _____	_____

RECEIVED
 DEC 30 3 39 PM '97
 Register of Deeds
 BAY COUNTY, MICHIGAN

Register of Deeds Stamp & File Number

4. Lot No. _____, Recorded Plat _____

5. Private Claims _____

I, PAUL M. CIOSEK, in a field survey on JULY 24, 1997 do hereby state that under requirements of P.A. 74, Michigan P.A. of 1970, the corner points mentioned in lines 1 and 2 above were in conformance with regulations and rules therefore as required in the current manual of survey instructions of the United States Department of the Interior, Bureau of Land Management or by a decree of a Court of Law and /or that the corner points mentioned in lines 3, 4 and 5 above were in conformance with the rules of the Michigan Board of Land Surveyors or by a Decree of a Court of Law; established, re-established, monumented, recovered, found as expressed below:

	A	B	C	D	E	F	G	H	I	J	K	L	M
1													
2	6		5		4		3		2		1		
3													
4	7		8		9		10		11		12		
5													
6	18		17		16		15		14		13		
7													
8	19		20		21		22		23		24		
9													
10	30		29		28		27		26		25		
11													
12	31		32		33		34		35		36		
13													

NOTE: Not more than 2 corners, all in the same town and range, may be recorded on this certificate.

A. Description of original monument and accessories and/or subsequent restoration:

- M-2
- POST SET BY J. WAMPLER D.S., 1822
ASH 16", N 22°W 12 LINKS
ASH 9" N 86°W 33 LINKS
CORNER IS COMMON WITH A-2, T16N, R4E
 - LCRC, L. 1, P. 307, GOSS (DECEMBER 1972) FND IRON
 - LCRC, L. 1, P. 331, GOSS (DECEMBER 1972) FND IRON
 - LCRC, L. 1, P. 557, GOSS (MARCH 1973) 3/8" IRON
 - SURVEY, L. 711, P.583, MCGINNIS,(6/1/73) FND PIPE
 - SURVEY, L. 799, P.12, MCGINNIS,(8/25/76) FND PIPE
 - SURVEY, L. 812, P.236, MCGINNIS,(4/6/77) FND 3/8" REROD
 - SURVEY, L. 860, P.53, MCGINNIS,(1/8/79) FND 3/8" IRON
 - SURVEY, L. 860, P.52, MCGINNIS,(1/8/79) FND 3/8" IRON
 - LCRC, L. 4, P. 7, D. RICHARDSON (4/17/97) FND 3/8" ROD

B. Description of corner evidence found and/or method applied in restoring or reestablishing corner:


M-2
SEARCHED THE LOCATION OF THE APPARENT CORNER AND FOUND A 3/8" REROD 0.65' BELOW ROAD SURFACE. BELOW THE 3/8" REROD FOUND A 2" x 15" SOLID BAR LEANING, THE TOP BEING 0.2' SE OF 3/8" REROD AND 0.8' BELOW ROAD SURFACE. ACCEPTED THE 3/8" REROD AS THE BEST AVAILABLE EVIDENCE OF THE POSITION OF THE ORIGINAL CORNER.

C. Description of monument for corner and accessories established to perpetuate locating the position of the corner:

- M-2
REPLACED FOUND 3/8" REROD WITH 5/8" REROD WITH BAY COUNTY REMONUMENTATION CAP WITH 3/16" DRILL HOLE IN MONUMENT BOX.
N 45°E 19.86' SET CAPPED 3/8" REROD
N 60° E 36.11' SET N/T IN 4" x 4" WOOD POST
EAST 15.80' (15.7' R) & (16.2 R) TO SOUTH LEG STREET SIGN
S 40°E 19.84' SET CAPPED 3/8" REROD
S 40°W 32.66' CHISELED "X" ON SOUTH END OF CONC. PIPE
S 50°W 24.93' SET CAPPED 3/8" REROD
S 45°W 65.58' FOUND MSHD TAG IN E. FACE U. POLE
N 30°W 22.01' SET CAPPED 3/8" REROD
N 45°W 28.89' (28.6' R.) CHISELED "X" ON NORTH END OF CONC. CULVERT
N 45°W 44.14' TO CL STREET SIGN

Signed by Paul M. Ciosek
Surveyor's Michigan License No. 25835

Date 12/22/97

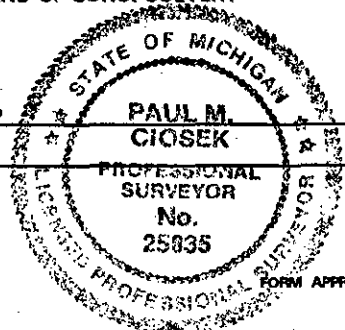

FIELD BOOK , PAGE 77

APPROVED LAND CORNER
P.A. 345 OF 1990 - Bay County
Date 21 July 97
HJM
Michael MacDonald P.S.