

**BAY COUNTY REMONUMENTATION  
LAND CORNER RECORDATION CERTIFICATE  
Filing Requirement of Act 74, Mich. P.A. 1970**

*Register of Deeds*  
**REGISTER OF DEEDS  
BAY COUNTY, MICHIGAN**

**DEC 30 3 40 PM '97**

RECORDED

For corners in

<u>BAY COUNTY</u> (County)	Located In:	Corner Code #
1. Public Land Survey	<u>T16N R3E</u>	<u>M-7</u>
	<u>T16N R4E</u>	<u>A-7</u>
	T___ R___	_____
	T___ R___	_____
2. Property Controlling in Section	S___ T___ R___	_____
	S___ T___ R___	_____
3. Miscellaneous Property in Sec.	S___ T___ R___	_____
	S___ T___ R___	_____

Register of Deeds Stamp & File Number

4. Lot No. \_\_\_\_\_, Recorded Plat \_\_\_\_\_

5. Private Claims \_\_\_\_\_

I, Paul M. Ciosek, in a field survey on JUNE 19, 1997 do hereby state that under requirements of P.A. 74, Michigan P.A. of 1970, the corner points mentioned in lines 1 and 2 above were in conformance with regulations and rules therefore as required in the current manual of survey instructions of the United States Department of the Interior, Bureau of Land Management or by a decree of a Court of Law and/or that the corner points mentioned in lines 3, 4 and 5 above were in conformance with the rules of the Michigan Board of Land Surveyors or by a Decree of a Court of Law; established, re-established, monumented, recovered, found as expressed below:

**NOTE: Not more than 2 corners, all in the same town and range, may be recorded on this certificate.**

	A	B	C	D	E	F	G	H	I	J	K	L	M
1													
2	6		5		4		3		2		1		
3													
4	7		8		9		10		11		12		
5													
6	10		17		16		15		14		13		
7													
8	19		20		21		22		23		24		
9													
10	30		29		28		27		26		25		
11													
12	31		32		33		34		35		36		
13													

**A. Description of original monument and accessories and/or subsequent restoration:**

M-7  
1. POST SET BY J. WAMPLER D.S. 1822  
LYNN 6" S 1/2° E 21 LINKS  
HEMLOCK, 40" N 67°W 2 LINKS  
CORNER IS COMMON WITH A-7, T16N, R4E  
2. SURVEY, L. 759, P. 36, GOSS, (4/2/75) NO CALL  
3. EDMANDS WITNESSES, MACDONALD, (3/2/76) 3/8" IRON  
4. LCRC, L. 2, P. 303, MCGINNIS, (3/21/77) 3/4" x 1 1/2" IRON  
6. SURVEY, L. 1215, P. 262, MCGINNIS, NO CALL

**B. Description of corner evidence found and/or method applied in restoring or reestablishing corner:**

M-7  
SEARCHED THE APPARENT LOCATION OF THE CORNER AND FOUND 2" x 3/4" BAR 18" LONG WITH A POINT ON THE END AT THE ROAD SURFACE. AT 16" BELOW THE SURFACE FOUND 4 LARGE ROCKS AROUND THE BAR ALONG WITH TWO ±6" LONG PIECES OF WOOD. ACCEPTED THE 2" x 3/4" BAR AS THE BEST AVAILABLE EVIDENCE OF THE POSITION OF THE ORIGINAL CORNER.

**C. Description of monument for corner and accessories established to perpetuate locating the position of the corner:**


M-7 REPLACED FOUND 2" x 3/4" BAR WITH A 5/8" X 24" REROD AND REMONUMENTATION CAP WITH 3/16" DRILL HOLE IN MONUMENT BOX.  
N 45°E 30.90' SET CAPPED 3/8" REROD  
N 60°E 39.64' WEST FACE STOP SIGN POST  
S 50°E 41.60' SET N/T NE FACE CUTOFF U. POLE (41.9 R) (41.6 R)  
S 45°E 34.19' SET CAPPED 3/8" REROD  
S 45°W 18.54' SET CAPPED 3/8" REROD  
S 60°W 26.70' EAST FACE STOP SIGN POST  
N 45°W 25.07' SET CAPPED 3/8" REROD  
N 40°E 61.09' SET N/T NE FACE PP (60.75' FACE R)

Signed by Paul M. Ciosek

Date 12/22/97

Surveyor's Michigan License No. 25835

FIELD BOOK , PAGE \_\_\_\_\_

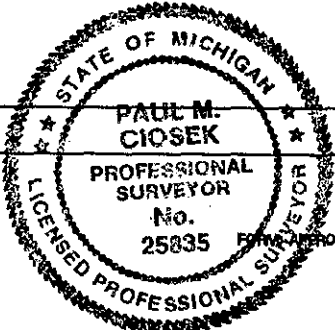

APPROVED LAND CORNER  
P.A. 345 OF 1990 - Bay County  
Date 27 June 97  
MJM  
Michael MacDonald P.S.  
County Representative

FORM APPROVED BY MICHIGAN STATE BOARD OF PROFESSIONAL SURVEYORS, JAN. 28, 1971  
REVISED MAY 14, 197  
REVISED JAN., 198  
REVISED OCT., 198