

**BAY COUNTY REMONUMENTATION
LAND CORNER RECORDATION CERTIFICATE
Filing Requirement of Act 74, Mich. P.A. 1970**

For corners in

<u>BAY COUNTY</u> (County)	Located In:	Corner Code #
1. Public Land Survey	T16N R3E	<u>M-8</u>
	T16N R4E	<u>A-8</u>
	T___ R___	_____
	T___ R___	_____
2. Property Controlling in Section	S___ T___ R___	_____
	S___ T___ R___	_____
3. Miscellaneous Property in Sec.	S___ T___ R___	_____
	S___ T___ R___	_____

Dec 30 3 40 PM '97
 REGISTER OF DEEDS
 BAY COUNTY, MICHIGAN

RECORDED

Register of Deeds Stamp & File Number

4. Lot No. _____, Recorded Plat _____

5. Private Claims _____

	A	B	C	D	E	F	G	H	I	J	K	L	M
1													
2	6		5		4		3		2		1		
3													
4	7		8		9		10		11		12		
5													
6	18		17		16		15		14		13		
7													
8	19		20		21		22		23		24		
9													
10	30		29		28		27		26		25		
11													
12	31		32		33		34		35		36		
13													

I, Paul M. Ciosek, in a field survey on OCTOBER 13, 1997 do hereby state that under requirements of P.A. 74, Michigan P.A. of 1970, the corner points mentioned in lines 1 and 2 above were in conformance with regulations and rules therefore as required in the current manual of survey instructions of the United States Department of the Interior, Bureau of Land Management or by a decree of a Court of Law and /or that the corner points mentioned in lines 3, 4 and 5 above were in conformance with the rules of the Michigan Board of Land Surveyors or by a Decree of a Court of Law; established, re-established, monumented, recovered, found as expressed below:

NOTE: Not more than 2 corners, all in the same town and range, may be recorded on this certificate.

A. Description of original monument and accessories and/or subsequent restoration:

- M-8
- POST SET BY J. WAMPLER D.S. 1822
LYNN 10° N 61° E 2.5 LINKS
SUGAR 8° N 35°W 20 LINKS
CORNER IS COMMON WITH A-8, T16N, R4E
 - SURVEY, UNRECORDED, DELAMATER, (5/15/68) NO CALL
 - SURVEY, L. 759, P. 36, GOSS, (4/2/75) FND 3/8" REROD
 - LCRC, L. 2, P. 303, MCGINNIS, (3/21/77) 3/8" REROD
 - SURVEY, L. 1257, P. 578, CIOSEK (12/8/920, FND 3/8" REROD

B. Description of corner evidence found and/or method applied in restoring or reestablishing corner:


M-8
SEARCHED THE APPARENT LOCATION OF THE CORNER AND FOUND NO EVIDENCE OF A CORNER. RESET CORNER PER ANGLE AND DISTANCE FROM WADE-TRIM FIELD NOTES OF SURVEY RECORDED IN L. 1257, P. 578. LOCATION OF RESET POINT ACCEPTED AS THE BEST AVAILABLE EVIDENCE OF THE POSITION OF THE ORIGINAL CORNER.

C. Description of monument for corner and accessories established to perpetuate locating the position of the corner:

M-8 SET 5/8" x 24" REROD WITH BAY COUNTY REMONUMENTATION CAP WITH 3/16" DRILL HOLE IN MONUMENT BOX.
 N 50°E 21.59' SET CAPPED 3/8" REROD
 EAST 29.50' SET N/T IN NORTH FACE WOOD POST - (FACE 29.3' R)
 S 45°E 23.33' SET CAPPED 3/8" REROD
 S 40°W 18.77' SET CAPPED 3/8" REROD
 N 40°W 16.92' SET CAPPED 3/8" REROD
 N 30°W 38.32' SET MAG NAIL SOUTH END 12" PLASTIC PIPE
 N 30°W 81.05' SET MAG NAIL WEST END CMP (80.35' R, C/L W. END)

Signed by Paul M. Ciosek
 Surveyor's Michigan License No. 25835
 FIELD BOOK , PAGE 29

Date 12/22/97

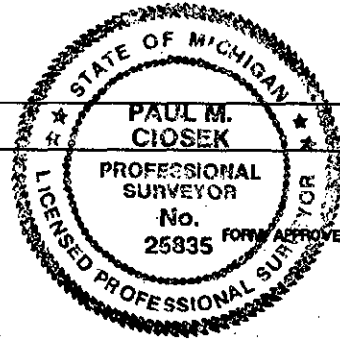

APPROVED LAND CORNER
 P.A. 345 OF 1990 - Bay County
 Date 22 Oct 1997
MJM
 Michael MacDonald P.S.
 County Representative

004 87

FORM APPROVED BY MICHIGAN STATE BOARD OF PROFESSIONAL SURVEYORS, JAN. 28, 1971
 REVISED MAY 14, 197
 REVISED JAN., 199
 REVISED OCT., 199