

**BAY COUNTY REMONUMENTATION  
LAND CORNER RECORDATION CERTIFICATE  
Filing Requirement of Act 74, Mich. P.A. 1970**

For corners in

<u>BAY</u> (County)	Located in:	Corner Code #
1. Public Land Survey	T <u>16N</u> R <u>3E</u>	<u>M-3</u>
	T <u>16N</u> R <u>4E</u>	<u>A-3</u>
	T _____ R _____	_____
	T _____ R _____	_____
2. Property Controlling in Section	S _____ T _____ R _____	_____
	S _____ T _____ R _____	_____
3. Miscellaneous Property in Sec.	S _____ T _____ R _____	_____
	S _____ T _____ R _____	_____

REGISTER OF DEEDS  
 BAY COUNTY, MICHIGAN  
 JAN 6 10 11 AM '98  
 RECORDED  
 Register of Deeds Stamp & File Number

4. Lot No. \_\_\_\_\_, Recorded Plat \_\_\_\_\_

5. Private Claims \_\_\_\_\_

1	A	B	C	D	E	F	G	H	I	J	K	L	M
2	6		5		4		3		2		1		
3													
4	7		8		9		10		11		12		
5													
6	18		17		16		15		14		13		
7													
8	19		20		21		22		23		24		
9													
10	30		29		28		27		26		25		
11													
12	31		32		33		34		35		36		
13													

I, PAUL M. CIOSEK, in a field survey on AUGUST 3, 1997 do hereby state that under requirements of P.A. 74, Michigan P.A. of 1970, the corner points mentioned in lines 1 and 2 above were in conformance with regulations and rules therefore as required in the current manual of survey instructions of the United States Department of the Interior, Bureau of Land Management or by a decree of a Court of Law and for that the corner points mentioned in lines 3, 4 and 5 above were in conformance with the rules of the Michigan Board of Land Surveyors or by a Decree of a Court of Law; established, re-established, monumented, recovered, found as expressed below:

**NOTE: Not more than 2 corners, all in the same town and range, may be recorded on this certificate.**

**A. Description of original monument and accessories and/or subsequent restoration:**

- M-3
- POST SET BY J. WAMPLER D.S., 1822 HEMLOCK 7", S 1°E 10 LINKS BEECH 20" S 85°E 3.5 LINKS CORNER IS COMMON WITH A-3 T16N, R4E
  - LCRC, L. 1, P. 331, GOSS (DECEMBER 1972) IRON
  - LCRC, L. 1, P. 441, GOSS (DECEMBER 1972) FND SEC. CORNER
  - SURVEY, L. 745, P.512, MCGINNIS,(8/9/74) FND IRON
  - SURVEY, L. 799, P.12, MCGINNIS,(8/25/76) FND 3/8" IRON
  - SURVEY, L. 860, P.52,.53, MCGINNIS,(1/8/79) FND - NO CALL
  - LCRC, L. 4, P. 6, D. RICHARDSON (4/17/97) FND 1/2" ROD

**B. Description of corner evidence found and/or method applied in restoring or reestablishing corner:**


M-3  
SEARCHED THE LOCATION OF THE APPARENT CORNER AND FOUND A 1/2" REROD OF RECORD 3" BELOW ROAD SURFACE. FOUND NO OTHER OBJECTS IN THE AREA. ACCEPTED THE 1/2" REROD AS THE BEST AVAILABLE EVIDENCE OF THE POSITION OF THE ORIGINAL CORNER.

**C. Description of monument for corner and accessories established to perpetuate locating the position of the corner:**

M-3  
REPLACED FOUND 1/2" REROD WITH 5/8" X 24" REROD WITH BAY COUNTY REMONUMENTATION CAP WITH 3/16" DRILL HOLE IN MONUMENT BOX.  
 N 45°E 91.20' (91.15' R.) & (91.30' R) SW CORNER OF BRICK HOUSE  
 N 50° E 47.35' FND PS 18999  
 N 30° E 21.35' SET N/T W. FACE LIGHT POLE  
 N 30°W 53.03' (52.98 R) SET N/T IN W. FACE GUARD POST  
 S 50°W 144.10' SET N/T IN SW FACE U. POLE  
 S 55°W 21.52' (21.45' R.) FND CHISELED "X" IN TOP CENTERLINE RCP  
 S 45°E 45.30'(45.24' R.) 1 1/2" PIPE 2.5' ABOVE GROUND  
 S 60°E 29.02' SET CHISELED "X" IN TOP CENTERLINE RCP

Signed by Paul M. Ciosek  
 Surveyor's Michigan License No. 25835

Date 12/31/97

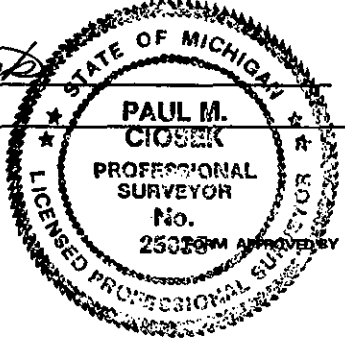

FIELD BOOK , PAGE 78

APPROVED LAND CORNER  
 P.A. 345 OF 1990 - Bay County  
 Date 2/1 Aug 97  
MJM  
 Michael MacDonald P.S.