

**BAY COUNTY REMONUMENTATION
LAND CORNER RECORDATION CERTIFICATE
Filing Requirement of Act 74, Mich. P.A. 1970**

For corners in

<u>BAY</u> (County)	Located in:	Corner Code #
1. Public Land Survey	T 16N R 3E	<u>M-4</u>
	T 16N R 4E	<u>A-4</u>
	T _____ R _____	_____
	T _____ R _____	_____
2. Property Controlling in Section	S _____ T _____ R _____	_____
	S _____ T _____ R _____	_____
3. Miscellaneous Property in Sec.	S _____ T _____ R _____	_____
	S _____ T _____ R _____	_____

REGISTER OF DEEDS
 BAY COUNTY, MICHIGAN
 Dec 30 3 39 PM '97
 REGISTERED
 Register of Deeds Stamp & File Number

4. Lot No. _____, Recorded Plat _____

5. Private Claims _____

	A	B	C	D	E	F	G	H	I	J	K	L	M
1													
2	6		5		4		3		2		1		
3													
4	7		8		9		10		11		12		
5													
6	18		17		16		15		14		13		
7													
8	19		20		21		22		23		24		
9													
10	30		29		28		27		26		25		
11													
12	31		32		33		34		35		36		
13													

I, PAUL M. CIOSEK, in a field survey on AUGUST 29, 1997 do hereby state that under requirements of P.A. 74, Michigan P.A. of 1970, the corner points mentioned in lines 1 and 2 above were in conformance with regulations and rules therefore as required in the current manual of survey instructions of the United States Department of the Interior, Bureau of Land Management or by a decree of a Court of Law and /or that the corner points mentioned in lines 3, 4 and 5 above were in conformance with the rules of the Michigan Board of Land Surveyors or by a Decree of a Court of Law; established, re-established, monumented, recovered, found as expressed below:

NOTE: Not more than 2 corners, all in the same town and range, may be recorded on this certificate.

A. Description of original monument and accessories and/or subsequent restoration:

- M-4
- POST SET BY J. WAMPLER D.S., 1822
HEMLOCK 32°, S 35°E 7 LINKS
CORNER IS COMMON WITH A-4, T16N, R4E
 - UNRECORDED EDMANDS SURVEY, JOB #1848, 1962, NO CALL
 - SURVEY, L. 745, P.512, MCGINNIS (8/9/74) FND. 5 STONES 4" D. TO 5" x 15" IN CENTERLINE OF ROAD AND FENCE TO WEST. SET 1" PIPE IN CENTER.
 - LCRC, L. 2, P. 91, MCGINNIS (8/1/74) 4" CONCRETE MONUMENT
 - LCRC, L. 2, P. 321, MCGINNIS (3/21/77) 3/8" IRON
 - SURVEY, L. 860, P.52, 53, MCGINNIS (1/8/79) FND - NO CALL

B. Description of corner evidence found and/or method applied in restoring or reestablishing corner:


M-4
SEARCHED THE LOCATION OF THE APPARENT CORNER AND FOUND A 1" PIPE OF RECORD 20" LONG WITH 3 ROCKS AROUND PIPE 10" BELOW SURFACE. PIPE WAS SET IN SURVEY, L. 745, P.512 BY MCGINNIS. FOUND NO OTHER OBJECTS IN THE AREA. ACCEPTED THE 1" PIPE AS THE BEST AVAILABLE EVIDENCE OF THE POSITION OF THE ORIGINAL CORNER.

C. Description of monument for corner and accessories established to perpetuate locating the position of the corner:

M-4
REPLACED FOUND 1" PIPE WITH 5/8" X 24" REROD WITH BAY COUNTY REMONUMENTATION CAP WITH 3/16" DRILL HOLE IN MONUMENT BOX.
N 45°E 40.08' SET CAPPED 3/8" REROD
N 70° E 48.95' CENTERLINE STOP SIGN POST
S 40° E 39.20' SET CAPPED 3/8" REROD
S 40°W 11.97' SET CAPPED 3/8" REROD
WEST 29.06' SET N/T IN N. FACE 8" WOOD POST
N 40°W 13.14' SET CAPPED 3/8" REROD
N 20°W 79.61' SET N/T IN E. FACE SOUTHERLY 4" TWIN ELM

Signed by Paul M. Ciosek
Surveyor's Michigan License No. 25835
FIELD BOOK , PAGE 79

Date 12/22/97

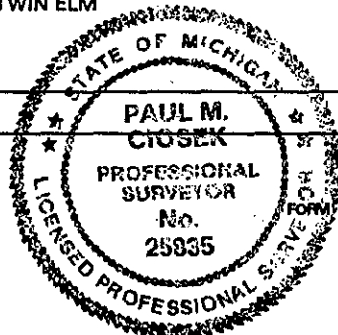

FORM APPROVED BY MICHIGAN STATE BOARD OF PROFESSIONAL SURVEYORS, JAN. 28, 197
REVISED MAY 14, 197
REVISED JAN., 199
REVISED OCT., 199

APPROVED LAND CORNER
P.A. 345 OF 1990 - Bay County
Date 11 Sept 97
MJM
Michael MacDonald P.S.
County Representative