

**BAY COUNTY REMONUMENTATION
LAND CORNER RECORDATION CERTIFICATE
Filing Requirement of Act 74, Mich. P.A. 1970**

For corners in

<u>BAY COUNTY</u> (County)	Located In:	Corner Code #
1. Public Land Survey	T16N R3E T16N R4E T____ R____ T____ R____	M-6 <u>A-6</u> _____ _____
2. Property Controlling in Section	S____ T____ R____ S____ T____ R____	_____ _____
3. Miscellaneous Property in Sec.	S____ T____ R____ S____ T____ R____	_____ _____

REGISTER OF DEEDS
 BAY COUNTY, MICHIGAN
 Dec 30 3 39 PM '97

RECORDED

Register of Deeds Stamp & File Number

4. Lot No. _____, Recorded Plat _____

5. Private Claims _____

I, Paul M. Ciosek, in a field survey on OCTOBER 13, 1997 do hereby state that under requirements of P.A. 74, Michigan P.A. of 1970, the corner points mentioned in lines 1 and 2 above were in conformance with regulations and rules therefore as required in the current manual of survey instructions of the United States Department of the Interior, Bureau of Land Management or by a decree of a Court of Law and for that the corner points mentioned in lines 3, 4 and 5 above were in conformance with the rules of the Michigan Board of Land Surveyors or by a Decree of a Court of Law; established, re-established, monumented, recovered, found as expressed below:

NOTE: Not more than 2 corners, all in the same town and range, may be recorded on this certificate.

	A	B	C	D	E	F	G	H	I	J	K	L	M
1													
2	6		5		4		3		2		1		
3													
4	7		8		9		10		11		12		
5													
6	18		17		16		15		14		13		
7													
8	19		20		21		22		23		24		
9													
10	30		29		28		27		26		25		
11													
12	31		32		33		34		35		36		
13													

A. Description of original monument and accessories and/or subsequent restoration:

- M-6
- POST SET BY J. WAMPLER D.S. 1822
HEMLOCK 20° S 53° E 13 LINKS
BIRCH 18° N 30° W 15 LINKS
CORNER IS COMMON WITH A-6, T16N, R4E
 - SURVEY, L. 803, P. 341, MCGINNIS, (11/16/76) 3/8" IRON
 - LCRC, L.12 P. 261, MACDONALD, (3/18/77) 3/8" IRON
 - SURVEY, L. 812, P. 209, MCGINNIS, (3/12/77) 3/8" IRON
 - SURVEY, UNRECORDED, LEDY #21575, (9/3/91) NO CALL

B. Description of corner evidence found and/or method applied in restoring or reestablishing corner:


M-6
SEARCHED THE APPARENT LOCATION OF THE CORNER AND FOUND 3/8" x 18" LONG REROD. VERIFIED LOCATION FROM WITNESSES. EXCAVATED THE AREA AND FOUND NO OTHER OBJECTS IN THE AREA. ACCEPTED 3/8" REROD AS THE BEST AVAILABLE EVIDENCE OF THE POSITION OF THE ORIGINAL CORNER.

C. Description of monument for corner and accessories established to perpetuate locating the position of the corner:

M-6 REPLACED FOUND 3/8" REROD WITH 5/8" X 24" REROD AND REMONUMENTATION CAP WITH 3/16" DRILL HOLE IN MON BOX
N 45°E 16.54' SET CAPPED 3/8" REROD.
N 80°E 20.93' SET MAG NAIL IN SOUTH END OF 12" PLASTIC CULVERT
S 45°E 92.40'(92.20' R.) TO NW CORNER HOUSE #1742 FOUNDATION
S 05°E 112.01' FOUND N/T 9433 IN N. FACE U. POLE
WEST 46.99' FOUND N/T 9433 IN N. FACE U. POLE
N 40°W 21.10' SET, CAPPED 3/8" REROD

Signed by Paul M. Ciosek
Surveyor's Michigan License No. 25835
FIELD BOOK , PAGE 15

Date 12/22/97

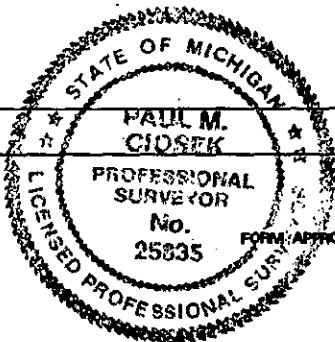

FORM APPROVED BY MICHIGAN STATE BOARD OF PROFESSIONAL SURVEYORS, JAN. 28, 1971
REVISED MAY 14, 197
REVISED JAN., 199
REVISED OCT., 199

APPROVED LAND CORNER
P.A. 345 OF 1990 - Bay County
Date 23 Oct 97
MJM
Michael MacDonald P.S.
County Representative