

**BAY COUNTY REMONUMENTATION
LAND CORNER RECORDATION CERTIFICATE
Filing Requirement of Act 74, Mich. P.A. 1970**

Register of Deeds, Bay County, Michigan
Dec 30 3 40 PM '97

RECORDED

For corners in

<u>BAY COUNTY</u> (County)	Located In:	Corner Code #
1. Public Land Survey	T16N R3E	M-7
	T16N R4E	A-7
	T R	
	T R	
2. Property Controlling in Section	S T R	
	S T R	
3. Miscellaneous Property in Sec.	S T R	
	S T R	

Register of Deeds Stamp & File Number

4. Lot No. _____, Recorded Plat _____

5. Private Claims _____

	A	B	C	D	E	F	G	H	I	J	K	L	M
1													
2	6		5		4		3		2		1		
3													
4	7		8		9		10		11		12		
5													
6	18		17		16		15		14		13		
7													
8	19		20		21		22		23		24		
9													
10	30		29		28		27		26		25		
11													
12	31		32		33		34		35		36		
13													

I, Paul M. Ciosek, in a field survey on JUNE 19, 1997 do hereby state that under requirements of P.A. 74, Michigan P.A. of 1970, the corner points mentioned in lines 1 and 2 above were in conformance with regulations and rules therefore as required in the current manual of survey instructions of the United States Department of the Interior, Bureau of Land Management or by a decree of a Court of Law and /or that the corner points mentioned in lines 3, 4 and 5 above were in conformance with the rules of the Michigan Board of Land Surveyors or by a Decree of a Court of Law; established, re-established, monumented, recovered, found as expressed below:

NOTE: Not more than 2 corners, all in the same town and range, may be recorded on this certificate.

A. Description of original monument and accessories and/or subsequent restoration:

- M-7
- POST SET BY J. WAMPLER D.S. 1822
LYNN 6" S 1/2" E 21 LINKS
HEMLOCK, 40" N 67"W 2 LINKS
CORNER IS COMMON WITH A-7, T16N, R4E
 - SURVEY, L. 759, P. 36, GOSS, (4/2/75) NO CALL
 - EDMANDS WITNESSES, MACDONALD, (3/2/76) 3/8" IRON
 - LCRC, L. 2, P. 303, MCGINNIS, (3/21/77) 3/4" x 1 1/2" IRON
 - SURVEY, L. 1215, P. 262, MCGINNIS, NO CALL

B. Description of corner evidence found and/or method applied in restoring or reestablishing corner:

M-7
SEARCHED THE APPARENT LOCATION OF THE CORNER AND FOUND 2" x 3/4" BAR 18" LONG WITH A POINT ON THE END AT THE ROAD SURFACE. AT 16" BELOW THE SURFACE FOUND 4 LARGE ROCKS AROUND THE BAR ALONG WITH TWO ±6" LONG PIECES OF WOOD. ACCEPTED THE 2" x 3/4" BAR AS THE BEST AVAILABLE EVIDENCE OF THE POSITION OF THE ORIGINAL CORNER.


C. Description of monument for corner and accessories established to perpetuate locating the position of the corner:

M-7 REPLACED FOUND 2" x 3/4" BAR WITH A 5/8" X 24" REROD AND REMONUMENTATION CAP WITH 3/16" DRILL HOLE IN MONUMENT BOX.
N 45°E 30.90' SET CAPPED 3/8" REROD
N 60°E 39.64' WEST FACE STOP SIGN POST
S 50°E 41.60' SET N/T NE FACE CUTOFF U. POLE (41.9 R) (41.6 R)
S 45°E 34.19' SET CAPPED 3/8" REROD
S 45°W 18.54' SET CAPPED 3/8" REROD
S 60°W 26.70' EAST FACE STOP SIGN POST
N 45°W 25.07' SET CAPPED 3/8" REROD
N 40°E 61.09' SET N/T NE FACE PP (60.75' FACE R)

Signed by Paul M. Ciosek
Surveyor's Michigan License No. 25835

Date 12/22/97

FIELD BOOK , PAGE

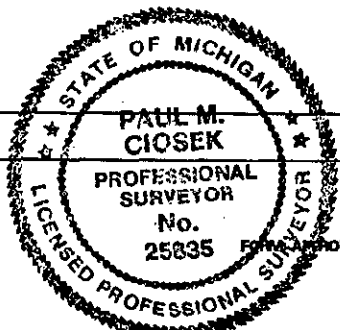

APPROVED LAND CORNER
P.A. 345 OF 1990 - Bay County
Date 27 June 97
HJM
Michael MacDonald P.S.
County Representative

APPROVED BY MICHIGAN STATE BOARD OF PROFESSIONAL SURVEYORS, JAN. 28, 1971
REVISED MAY 14, 197
REVISED JAN., 195
REVISED OCT., 199