

**BAY COUNTY REMONUMENTATION
LAND CORNER RECORDATION CERTIFICATE
Filing Requirement of Act 74, Mich. P.A. 1970**

For corners in

BAY COUNTY
(County)

Located In:

Corner Code #

1. Public Land Survey		T16N R3E	M-9
		T16N R4E	A-9
		T___ R___	_____
		T___ R___	_____
2. Property Controlling in Section	S___	T___ R___	_____
	S___	T___ R___	_____
3. Miscellaneous Property in Sec.	S___	T___ R___	_____
	S___	T___ R___	_____

Register of Deeds
 BAY COUNTY, MICHIGAN

DEC 30 3 40 PM '97

RECORDED

Register of Deeds Stamp & File Number

4. Lot No. _____, Recorded Plat _____

5. Private Claims _____

	A	B	C	D	E	F	G	H	I	J	K	L	M
1													
2	6		5		4		3		2		1		
3													
4	7		8		9		10		11		12		
5													
6	18		17		16		15		14		13		
7													
8	19		20		21		22		23		24		
9													
10	30		29		28		27		26		25		
11													
12	31		32		33		34		35		36		
13													

I, Paul M. Ciosek, in a field survey on JUNE 19, 1997 do hereby state that under requirements of P.A. 74, Michigan P.A. of 1970, the corner points mentioned in lines 1 and 2 above were in conformance with regulations and rules therefore as required in the current manual of survey instructions of the United States Department of the Interior, Bureau of Land Management or by a decree of a Court of Law and for that the corner points mentioned in lines 3, 4 and 5 above were in conformance with the rules of the Michigan Board of Land Surveyors or by a Decree of a Court of Law; established, re-established, monumented, recovered, found as expressed below:

NOTE: Not more than 2 corners, all in the same town and range, may be recorded on this certificate.

A. Description of original monument and accessories and/or subsequent restoration:

- M-9
- POST SET BY J. WAMPLER D.S. 1822
HEMLOCK 30" S 60" W 6 LINKS
HEMLOCK 20" NORTH 22 LINKS
CORNER IS COMMON WITH A-9, T16N, R4E
 - SURVEY, L. 657, P. 279, DELAMATER(7/7/71) FOUND CORNER
 - SURVEY, L. 779, P. 407, MCGINNIS, (1/20/76) FND 1/2" BAR
 - LCRC, L. 2, P. 270, MACDONALD, (3/2/78) FND 1/2" IRON
 - SURVEY, L. 1257, P. 578, CIOSEK, (12/8/92) FND 1/2" IRON

B. Description of corner evidence found and/or method applied in restoring or reestablishing corner:


M-9
SEARCHED THE APPARENT LOCATION OF THE CORNER AND FOUND 5/8" REROD 6" BELOW ASPHALT ROAD SURFACE. DUG 30" BELOW ROAD SURFACE INTO 6" OF CLAY. FOUND NO OTHER OBJECTS. ACCEPTED 5/8" REROD AS THE BEST AVAILABLE EVIDENCE OF THE POSITION OF THE ORIGINAL CORNER.

C. Description of monument for corner and accessories established to perpetuate locating the position of the corner:

M-9
REPLACED FOUND 5/8" REROD WITH A 5/8" x 24" REROD AND REMONUMENTATION CAP WITH 3/16" DRILL HOLE IN MONUMENT BOX. N 30°E 42.79' SET NAIL AND TAG IN SOUTH FACE OF 6" SQUARE WOOD POST
N 19°E 115.84' FOUND PK IN WEST FACE PP
S 40°E 49.60" SET NAIL AND TAG IN NE FACE PP
S 40°W 48.96' SET NAIL AND TAG IN NW FACE PP
N 45°W 29.49' SET CAPPED 3/8" REROD
N 45°E 36.04' SET CAPPED 3/8" REROD

Signed by Paul M. Ciosek
Surveyor's Michigan License No. 25835
FIELD BOOK , PAGE 75

Date 12/22/97

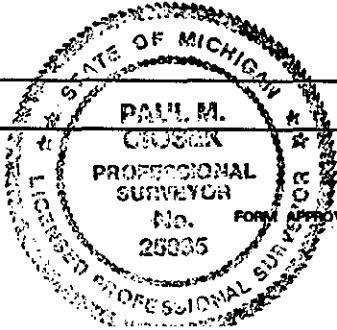

APPROVED LAND CORNER
P.A. 345 OF 1990 - Bay County
Date 27 June 97
MJM
Michael MacDonald P.S.

FORM APPROVED BY MICHIGAN STATE BOARD OF PROFESSIONAL SURVEYORS, JAN. 29, 1971

REVISED MAY 14, 197
REVISED JAN., 198
REVISED OCT., 198

004 88