

MAR 17 1999

BAY COUNTY REMONUMENTATION 1998

LAND CORNER RECORDATION CERTIFICATE
Filing Requirement of Act 74, Mich. P.A. 1970

SECTION

For corners in

| Bay (County) | Located In: Mt. Forest Twp. | Corner Code # |
|---------------------------------------|--------------------------------|---------------|
| 1. Public Land Survey | T <u>17 N</u> R <u>3 E</u> | <u>B-11</u> |
| | T _____ R _____ | _____ |
| | T _____ R _____ | _____ |
| | T _____ R _____ | _____ |
| 2. Property Controlling in Section | S _____ T _____ R _____ | _____ |
| | S _____ T _____ R _____ | _____ |
| 3. Miscellaneous Property in Sec. | S _____ T _____ R _____ | _____ |
| | S _____ T _____ R _____ | _____ |

REGISTER OF DEEDS
BAY COUNTY, MICHIGAN

1998 DEC 28 A 9:09

RECORDED

Register of Deeds Stamp & File Number

4. Lot No. _____, Recorded Plat _____
5. Private Claims _____

I, Ronald C. Prevost, in a field survey on 6-28, 1998 do hereby state that under requirements of P.A. 74, Michigan P.A. of 1970, the corner points mentioned in lines 1 and 2 above were in conformance with regulations and rules therefore as required in the current manual of survey instructions of the United States Department of the Interior, Bureau of Land Management or by a decree of a Court of Law and /or that the corner points mentioned in lines 3, 4 and 5 above were in conformance with the rules of the Michigan Board of Land Surveyors or by a Decree of a Court of Law; established, re-established, monumented, recovered, found as expressed below:

NOTE: Not more than 2 corners, all in the same town and range, may be recorded on this certificate.

| | A | B | C | D | E | F | G | H | I | J | K | L | M |
|----|----|---|----|---|----|---|----|---|----|---|----|---|---|
| 1 | | | | | | | | | | | | | |
| 2 | 6 | | 5 | | 4 | | 3 | | 2 | | 1 | | |
| 3 | | | | | | | | | | | | | |
| 4 | 7 | | 8 | | 9 | | 10 | | 11 | | 12 | | |
| 5 | | | | | | | | | | | | | |
| 6 | 18 | | 17 | | 16 | | 15 | | 14 | | 13 | | |
| 7 | | | | | | | | | | | | | |
| 8 | 19 | | 20 | | 21 | | 22 | | 23 | | 24 | | |
| 9 | | | | | | | | | | | | | |
| 10 | 30 | | 29 | | 28 | | 27 | | 26 | | 25 | | |
| 11 | | | | | | | | | | | | | |
| 12 | 31 | | 32 | | 33 | | 34 | | 35 | | 36 | | |
| 13 | | | | | | | | | | | | | |

A. Description of original monument and accessories and/or subsequent restoration:

- B-11 Post set by D.S. John Mullett, 1846.
Maple 10" N.7°E. 30 Lks.
W. Ash 8" S.19°W. 34 Lks.
Act 132 L676, P433 McGinnis 1972 iron set.
Act 132 L691, P283 Courtright 1972, no witnesses.
LCRC L1, P475 McGinnis 1972, iron.
Spicer Eng. notes 1975 fnd 1/4" rod. 1981 fnd 1/4" rod put 3/4" pipe over.
Act 132 L1185, P65, McGinnis 1991 no witnesses.
Act 132 L1185, P104, W/T, 1991 iron found.

B. Description of corner evidence found and/or method applied in restoring or reestablishing corner:


- B-11 Found 3/4" pipe, 0.2' below bit.
From L676, P433 & L1, P475, SE 36.30 face cor. fence post. (broken off dist. ok).
From Spicer notes 1975. NE 127.32 face P. pole (127.28M) East 28' extension on fence from South.
From L1185, P104 SE 36.3 to face end fence post. (broken off dist ok) E.28' to fence line to South.

Accepted as the best available evidence of the position of the original corner.

C. Description of monument for corner and accessories established to perpetuate locating the position of the corner:

- B-11 Replaced 3/4" pipe with 5/8" rod Bay Co. remon cap, placed mon box. Note; 3/4" pipe had 1/4" rod inside.
S.35°E. 40.60 face broken fence cor. post.
East 28.9 to ext of fence from South.
N.65°E 127.28 face of P. pole.
S.70°E. 31.90 ctr. 1" X 1/2" iron bar.
South 5' ± ctr. bit. rd.

APPROVED LAND CORNER
P.A. 345 OF 1990 - Bay County
Date 23 July 98
MJM
Michael MacDonald P.S.
County Representative

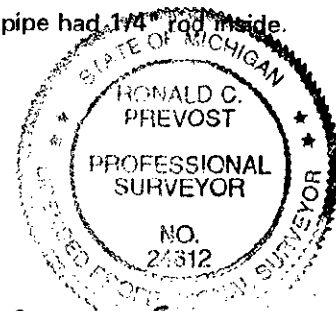

Signed by Ronald C. Prevost
Ronald C. Prevost

Date 12-18-98

Surveyor's Michigan License No. 24612