

MAR 17 1999

BAY COUNTY REMONUMENTATION 1998

SECTION

LAND CORNER RECORDATION CERTIFICATE
Filing Requirement of Act 74, Mich. P.A. 1970

For corners in

Bay (County)	Located In: Mt. Forest Twp.	Corner Code #
1. Public Land Survey	T <u>17 N</u> R <u>3 E</u>	<u>C-11</u>
	T _____ R _____	_____
	T _____ R _____	_____
	T _____ R _____	_____
2. Property Controlling in Section	S _____ T _____ R _____	_____
	S _____ T _____ R _____	_____
3. Miscellaneous Property in Sec.	S _____ T _____ R _____	_____
	S _____ T _____ R _____	_____

REGISTERED
 REGISTER OF DEEDS
 BAY COUNTY, MICHIGAN
 1998 DEC 28 A 9:09
 Recorder
 Register of Deeds Stamp & File Number
 RECORDED

4. Lot No. _____, Recorded Plat _____
 5. Private Claims _____

I, Ronald C. Prevost, in a field survey on 6-23, 1998 do hereby state that under requirements of P.A. 74, Michigan P.A. of 1970, the corner points mentioned in lines 1 and 2 above were in conformance with regulations and rules therefore as required in the current manual of survey instructions of the United States Department of the Interior, Bureau of Land Management or by a decree of a Court of Law and /or that the corner points mentioned in lines 3, 4 and 5 above were in conformance with the rules of the Michigan Board of Land Surveyors or by a Decree of a Court of Law; established, re-established, monumented, recovered, found as expressed below:

	A	B	C	D	E	F	G	H	I	J	K	L
1												
2	6		5		4		3		2		1	
3												
4	7		8		9		10		11		12	
5												
6	18		17		16		15		14		13	
7												
8	19		20		21		22		23		24	
9												
10	30		29		28		27		26		25	
11												
12	31		32		33		34		35		36	
13												

NOTE: Not more than 2 corners, all in the same town and range, may be recorded on this certificate.

A. Description of original monument and accessories and/or subsequent restoration:

- C-11 Post set by John Mullett D.S. 1846
- B. Ash 8" S.54°W. 39 L.
- B. Ash 12" N.87°E. 56 L.
- Cons. Pwr. Co. map corner set 1967.
- Act 132, L676, P433 Edmands, McGinnis #18999 1972 fnd iron.
- LCRC L1, P119 McGinnis #18999 1972 bar fnd.
- Act 132, L691, P283 Courtright #4672 1972 1/4" rod found.
- Spicer Eng. notes 1975 1/4" rod found.
- LCRC L2, P504 Sedgman #18664, 1979, 3/8" bar found.

B. Description of corner evidence found and/or method applied in restoring or reestablishing corner:

- C-11 Found 1/4" bar 0.3' below bit.
- From L676, P433, L01, P119, Spicer Eng. notes.
- NE 51.80 spike in T. pole. (51.80M).
- From L02, P 504
- N.40°E. 51.67 tel pole. (OK).
- From Spicer Notes 1975
- NE 51.80 nail W face T pole. (51.80M).
- NE 120.74 SW cor. blk fnd'n hse. (120.70M).
- NW 73.58 face p pole. (73.60M).

Accepted as the best available evidence of the position of the original corner.


C. Description of monument for corner and accessories established to perpetuate locating the position of the corner:

- C-11 Replaced 1/4" rod with 5/8" bar Bay Co. bronze re-mon cap set mon box. Note: 1/4" rod was inside 3/4" pipe.
- N.40°E. 51.80 nail NW face wood pole @ tel ped.
- N.49°E. 120.70 SW cor blk fnd'n hse.
- S.33°W.133.96 face p. pole.
- N.45°W. 73.60 face p. pole.

Signed by Ronald C. Prevost
 Ronald C. Prevost

APPROVED LAND CORNER
 P.A. 345 OF 1990 - Bay County
 Date 23 July 98
MJM
 Michael MacDonald P.S.
 County Representative

Date 12-18-98

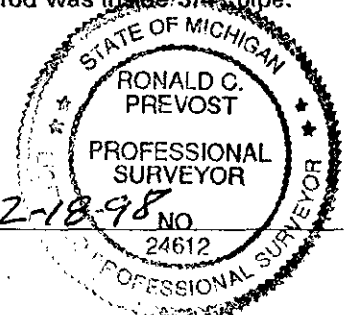

Surveyor's Michigan License No. 24612