

BAY COUNTY REMONUMENTATION 1998

MAR 17 1999

LAND CORNER RECORDATION CERTIFICATE
Filing Requirement of Act 74, Mich. P.A. 1970

SECTION

For corners in

Bay (County)	Located In: Mt. Forest Twp.	Corner Code #
1. Public Land Survey	T <u>17 N</u> R <u>3 E</u>	<u>E-11</u>
	T _____ R _____	_____
	T _____ R _____	_____
	T _____ R _____	_____
2. Property Controlling in Section	S _____ T _____ R _____	_____
	S _____ T _____ R _____	_____
3. Miscellaneous Property in Sec.	S _____ T _____ R _____	_____
	S _____ T _____ R _____	_____

Barbara Spence, Clerk
 REGISTER OF DEEDS
 BAY COUNTY, MICHIGAN

1998 DEC 28 A 9:09

RECORDED

Register of Deeds Stamp & File Number

4. Lot No. _____, Recorded Plat _____
 5. Private Claims _____

I, Ronald C. Prevost, in a field survey on 6-24, 1998 do hereby state that under requirements of P.A. 74, Michigan P.A. of 1970, the corner points mentioned in lines 1 and 2 above were in conformance with regulations and rules therefore as required in the current manual of survey instructions of the United States Department of the Interior, Bureau of Land Management or by a decree of a Court of Law and /or that the corner points mentioned in lines 3, 4 and 5 above were in conformance with the rules of the Michigan Board of Land Surveyors or by a Decree of a Court of Law; established, re-established, monumented, recovered, found as expressed below:

NOTE: Not more than 2 corners, all in the same town and range, may be recorded on this certificate.

	A	B	C	D	E	F	G	H	I	J	K	L	M
1													
2		6		5		4		3		2		1	
3													
4		7		8		9		10		11		12	
5													
6		18		17		16		15		14		13	
7													
8		19		20		21		22		23		24	
9													
10		30		29		28		27		26		25	
11													
12		31		32		33		34		35		36	
13													

A. Description of original monument and accessories and/or subsequent restoration:

E-11 Post set by John Mullett D.S. 1846.
 Sycm 12" S.37°E. 25 Lks.
 Sycm 10" N.72°W. 22 Lks.
 3/4" Pipe found 1967 Cons. Pwr. Co./Edmands map.
 Act 132 L1343, P526 McVean #39088, 3/8" re-bar found 1994.


B. Description of corner evidence found and/or method applied in restoring or reestablishing corner:

E-11 Found 3/8" re-bar 0.5' below bit. surface.
 From 1967 Con. Pwr. Co./Edmands map.
 SW 48.8 U.S.G.S. B.M. plug mon. (48.67M).
 NW 65.0 P. pole (64.90 nail in pole m)
 From L1343, P526
 N.65°E. 81.48 P.K. & tag SE side U.P. (81.50M).
 S.43°W. 48.69 U.S.G.S. brass cap (48.67M).
 N.36°W. 64.93 to capped nail in SE face U.P. (64.90M).
 N.42°W. 28.82 chiseled "+" N. end 48" conc. pipe (28.80M).

Accepted as the best available evidence of the position of the original corner.

C. Description of monument for corner and accessories established to perpetuate locating the position of the corner:

E-11 Replaced 3/8" re-bar with 5/8" bar, Bay Co. re-mon cap & mon box.
 N.65°E. 81.50 P.K. & tag SE face U.P.
 S.50°W. 48.67 U.S.G.S. brass cap mon.
 N.36°W. 28.80 chiseled "+" in N end 48" conc. pipe.
 N.42°W. 64.90 end of capped nail in SE face U.P.

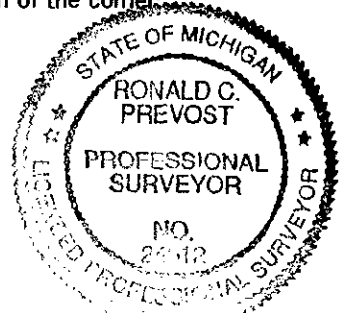

APPROVED LAND CORNER
 P.A. 345 OF 1990 - Bay County
 Date 23 July 98
MJM
 Michael MacDonald P.S.
 County Representative

Signed by Ronald C. Prevost
 Ronald C. Prevost

Date 12-18-98

Surveyor's Michigan License No. 24612