

MAR 17 1999

BAY COUNTY REMONUMENTATION 1998

LAND CORNER RECORDATION CERTIFICATE
Filing Requirement of Act 74, Mich. P.A. 1970

SECTION

For corners in

Bay (County)	Located in: Mt. Forest Twp.	Corner Code #
1. Public Land Survey	T <u>17 N</u> R <u>3 E</u>	<u>E-13</u> ✓
	T <u>16 N</u> R <u>3 E</u>	<u>E-1</u>
	T _____ R _____	_____
	T _____ R _____	_____
2. Property Controlling in Section	S _____ T _____ R _____	_____
	S _____ T _____ R _____	_____
3. Miscellaneous Property in Sec.	S _____ T _____ R _____	_____
	S _____ T _____ R _____	_____

REGISTER OF DEEDS
 BAY COUNTY, MICHIGAN
 1998 DEC 28 A 9:09
 RECORDED
 Register of Deeds Stamp & File Number

4. Lot No. _____, Recorded Plat _____
 5. Private Claims _____

	A	B	C	D	E	F	G	H	I	J	K	L	M
1													
2	6		5		4		3		2		1		
3													
4	7		8		9		10		11		12		
5													
6	18		17		16		15		14		13		
7													
8	19		20		21		22		23		24		
9													
10	30		29		28		27		26		25		
11													
12	31		32		33		34		35		36		
13													

I, Ronald C. Prevost, in a field survey on 6-11, 1998 do hereby state that under requirements of P.A. 74, Michigan P.A. of 1970, the corner points mentioned in lines 1 and 2 above were in conformance with regulations and rules therefore as required in the current manual of survey instructions of the United States Department of the Interior, Bureau of Land Management or by a decree of a Court of Law and for that the corner points mentioned in lines 3, 4 and 5 above were in conformance with the rules of the Michigan Board of Land Surveyors or by a Decree of a Court of Law; established, re-established, monumented, recovered, found as expressed below:

NOTE: Not more than 2 corners, all in the same town and range, may be recorded on this certificate.

A. Description of original monument and accessories and/or subsequent restoration:

E-13 Post set by D.S. H. Parke 1831.
 Maple 12" N.32°W. 40 Lks.
 Elm 14" N.60°E. 20 Lks.
 North between Secs 4 & 5, T.16 N.-R.3 E., 75.35 intersected North boundary at post. RE: E-1
 Iron set 1967 Con. Pwr. Co./Edmands map.
 Nine Act 132 surveys in T.16 N.-R.3 E. referring E-1 (common corner).
 Note: Corner E-13 T.17 N.- R.3 E., and corner E-1 T.16 N.-R.3 E., are Common.

B. Description of corner evidence found and/or method applied in restoring or reestablishing corner:


E-13 Found 5/8" iron bar 0.20' below gravel.
 From L740, P335, L759, P35, L798, P607, L812, P233, L829, P443, L833, P441, L1373, P479
 SW 63.45 to P. pole (63.41 P.K. in pole M).
 From Act 132 L1160, P856.
 SE. 87.12 spike in 30" cottonwood. (87.08M).
 SW. 63.50 P.K. in P. pole (63.41M).
 Dist. West from E-13 Con. Pwr. Co. 1967 map 2669.19 (2669.49M).
 Dist. North from E-13 Con. Pwr. Co. 1967 map 2743.18 (2742.34M).

Accepted as the best available evidence of the position of the original corner.

C. Description of monument for corner and accessories established to perpetuate locating the position of the corner:

E-13 Replaced 5/8" Iron bar with 5/8" Bay Co. iron bar, Bay Co. re-mon cap in mon box 6" below gravel:
 S.03°E. 87.08 spike in 30" Cottonwood.
 S.50°W. 63.41 P.K. nail SE face P. pole.
 N.45°W. 49.05 road sign post.
 N.82°E. 83.36 set mag nail in NW face 8" Twin Elm.

APPROVED LAND CORNER
 P.A. 345 OF 1990 - Bay County
 Date 23 July 98
MTM
 Michael MacDonald P.S.
 County Representative

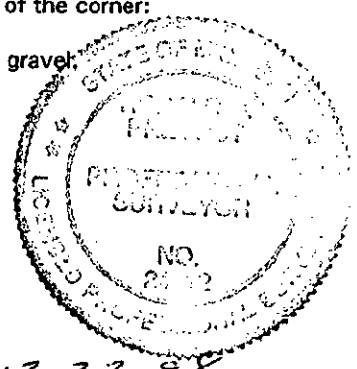

Signed by Ronald C. Prevost
 Ronald C. Prevost

Date 12-22-98

Surveyor's Michigan License No. 24612