

MAR 17 1998

BAY COUNTY REMONUMENTATION 1998

LAND CORNER RECORDATION CERTIFICATE
Filing Requirement of Act 74, Mich. P.A. 1970

For corners in

Bay (County) Located In: Mt. Forest Twp. Corner Code # F-13, F-1
1. Public Land Survey T 17 N R 3 E T 16 N R 3 E
2. Property Controlling in Section S T S T S T S T
3. Miscellaneous Property in Sec. S T S T S T S T

1998 DEC 28 A 9 09 REGISTERED REGISTER OF DEEDS BAY COUNTY, MICHIGAN RECORDED Register of Deeds Stamp & File Number

4. Lot No. , Recorded Plat
5. Private Claims

I, Ronald C. Prevost, in a field survey on 6-4, 1998 do hereby state that under requirements of P.A. 74, Michigan P.A. of 1970, the corner points mentioned in lines 1 and 2 above were in conformance with regulations and rules therefore as required in the current manual of survey instructions of the United States Department of the Interior, Bureau of Land Management or by a decree of a Court of Law and /or that the corner points mentioned in lines 3, 4 and 5 above were in conformance with the rules of the Michigan Board of Land Surveyors or by a Decree of a Court of Law; established, re-established, monumented, recovered, found as expressed below:

NOTE: Not more than 2 corners, all in the same town and range, may be recorded on this certificate.

Grid table with columns A-M and rows 1-13. A dot is marked at row 13, column G.

A. Description of original monument and accessories and/or subsequent restoration:

F-13 Post set by D.S. H. Parke 1831. Maple 13" N.86 1/2°W. 15 Lks. Beech 8" N.60 °E. 30 Lks. 1/2" rod shown on Act 132 L1160, P856, Ledy #21875, 1990. F-1 T.16 N.-R.3 E., not set during original Gov't survey. NOTE: Corners E-13 & G-13 are common with E-1 & G-1 to the East & to the West.


B. Description of corner evidence found and/or method applied in restoring or reestablishing corner:

F-13 Found 1/2" re-bar 3" below gravel surface, on apparent line to South, in line with a post North. Distance West as shown on L1160, P856, 2634.67, (2634.67M), very close to a single proportion location between E-13 & G-13, Dist. E. 2634.47. Accepted as the best available evidence of the position of the original corner.

C. Description of monument for corner and accessories established to perpetuate locating the position of the corner:

F-13 Replaced 1/2" rod with 5/8" rod. Bay Co. remon cap, in mon box 6" below gravel. N.56°E. 55.20 P.K. nail in NW face P. pole. S.07°W. 52.76 nail in W. face P. pole. S.60°W. 130.48 NE cor garage siding. S.40°E. 74.59 set mag nail NE face 12" Spruce.

APPROVED LAND CORNER P.A. 345 OF 1990 - Bay County Date 24 Sept 98 MJM Michael MacDonald P.S. County Representative

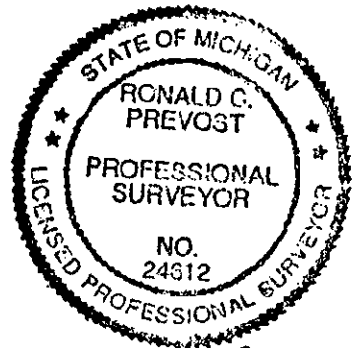

Signed by Ronald C. Prevost

Date 12-22-98

Surveyor's Michigan License No. 24612