

**BAY COUNTY REMONUMENTATION 1998  
LAND CORNER RECORDATION CERTIFICATE  
Filing Requirement of Act 74, Mich. P.A. 1970**

For corners in

<u>BAY</u> (County)	Located in:	Corner Code #
1. Public Land Survey	T <u>17N</u> R <u>3E</u>	<u>J-11</u>
	T _____ R _____	_____
2. Property Controlling	S _____ T _____ R _____	_____
3. Miscellaneous	S _____ T _____ R _____	_____
Property in Sec.	S _____ T _____ R _____	_____

*Barbara Jones Clark*  
 REGISTER OF DEEDS  
 BAY COUNTY, MICHIGAN

1999 JAN -5 A 9:05

RECORDED

Register of Deeds Stamp & File Number

4. Lot No. \_\_\_\_\_, Recorded Plat \_\_\_\_\_  
 5. Private Claims \_\_\_\_\_

I, BRIAN D FERGUSON in a field survey on OCTOBER, 19 98 do hereby state that under requirements of P.A. 74, Michigan P.A. of 1970, the corner points mentioned in lines 1 and 2 above were in conformance with regulations and rules therefore as required in the current manual of survey instructions of the United States Department of the Interior, Bureau of Land Management or by a decree of a Court of Law and/or that the corner points mentioned in lines 3, 4 and 5 above were in conformance with the rules of the Michigan Board of Land Surveyors or by a Decree of a Court of Law; established, re-established, monumented, recovered, found as expressed below:

A	B	C	D	E	F	G	H	I	J	K	L	M
1												
2	6		5		4		3		2			
3												
4	7		8		9		10		11		12	
5												
6	18		17		16		15		14		13	
7												
8	19		20		21		22		23		24	
9												
10	30		29		28		27		26		25	
11									⊕			
12	31		32		33		34		35		36	
13												

NOTE: Not more than 2 corners, all in the same town and range, may be recorded on this certificate.

A. Description of original monument and accessories and/or subsequent restoration:

WOOD POST SET BY H. PARKE IN 1831. NO EVIDENCE OF ORIGINAL CORNER REMAINS  
 8" BIRCH N26E 19 LINKS AND 8" ELM S55W 21 LINKS  
 LCRC REC IN L. 002, PG. 505  
 SURVEYS REC IN L. 919, PG 949 AND 876, PG 294

SURVEY &  
REMONUMENTATION

MAR 17 1999

SECTION

B. Description of corner evidence found and/or method applied in restoring or reestablishing corner:


FOUND 1/2" ROD PER LCRC AND RECORDED SURVEYS

ACCEPTED AS THE BEST AVAILABLE EVIDENCE OF THE LOCATION OF THE ORIGINAL CORNER

C. Description of monument for corner and accessories established to perpetuate locating the position of the corner:

SET 5/8" RE-BAR W / BAY COUNTY REMON. BRASS CAP & NO. 26454 IN MONUMENT BOX  
 S60°E 39.03' MAG NAIL S FCE 8" ELM  
 N70°W 46.30' MAG NAIL SE FCE 12" ELM  
 S00°W 32.93' 3/8" IRON W/WTI 18999  
 N30°E 80.11' MAG NAIL SE END OF E'LY BAG HEADWALL

APPROVED LAND CORNER  
 P.A. 345 OF 1990 - Bay County  
 Date 22 Oct 98  
MJM  
 Michael MacDonald P.S.  
 County Representative

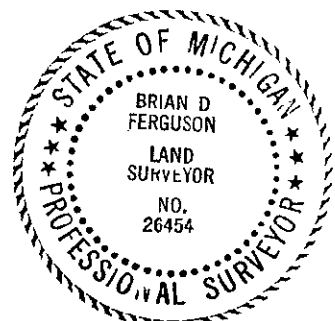

Signed by *Brian D Ferguson*  
 Surveyor's Michigan License No. 26454

Date December 23, 1998