

# SURVEY & REMONUMENTATION

APR 23 1998

## BAY COUNTY REMONUMENTATION LAND CORNER RECORDATION CERTIFICATE Filing Requirement of Act 74, Mich. P.A. 1970

REGISTER OF DEEDS  
 BAY COUNTY, MICHIGAN

DEC 30 3 38 PM '97

RECORDED

For corners in SECTION

BAY COUNTY <small>(County)</small>	Located In:	Corner Code #
1. Public Land Survey	T <u>17N</u> R <u>R3E</u>	<u>L-13</u>
	T _____ R _____	_____
	T _____ R _____	_____
	T _____ R _____	_____
2. Property Controlling in Section	S _____ T _____ R _____	_____
	S _____ T _____ R _____	_____
3. Miscellaneous Property in Sec.	S _____ T _____ R _____	_____
	S _____ T _____ R _____	_____

Register of Deeds Stamp & File Number

4. Lot No. \_\_\_\_\_, Recorded Plat \_\_\_\_\_

5. Private Claims \_\_\_\_\_

I, Paul M. Ciosok, in a field survey on OCTOBER 13, 19 97 do hereby state that under requirements of P.A. 74, Michigan P.A. of 1970, the corner points mentioned in lines 1 and 2 above were in conformance with regulations and rules therefore as required in the current manual of survey instructions of the United States Department of the Interior, Bureau of Land Management or by a decree of a Court of Law and /or that the corner points mentioned in lines 3, 4 and 5 above were in conformance with the rules of the Michigan Board of Land Surveyors or by a Decree of a Court of Law; established, re-established, monumented, recovered, found as expressed below:

	A	B	C	D	E	F	G	H	I	J	K	L	M
1													
2	6		5		4		3		2		1		
3													
4	7		8		9		10		11		12		
5													
6	18		17		16		15		14		13		
7													
8	19		20		21		22		23		24		
9													
10	30		29		28		27		26		25		
11													
12	31		32		33		34		35		36		
13													

**NOTE:** Not more than 2 corners, all in the same town and range, may be recorded on this certificate.

A. Description of original monument and accessories and/or subsequent restoration:

- L-13
1. POST SET BY HARVEY PARKE 1831  
HEMLOCK 10" N 88°W 3 LINKS  
SUGAR 7" S 57°E 33 LINKS
  2. SURVEY, L. 822, P. 533, MCGINNIS, (7/12/77) FOUND IRON
  3. SURVEY, L. 922, P. 327, LEDY, (5/20/92) CALL TO L-1 T16N, R3E, (7.98' R.)
  4. LCRC, L. 2, P. 549, LEDY, (5/20/82) CALL TO L-1 T16N, R3E, (7.98' R.)

B. Description of corner evidence found and/or method applied in restoring or reestablishing corner:

L-13 SEARCHED THE APPARENT LOCATION OF THE CORNER AND FOUND A 3/8" REROD 3" BELOW THE SURFACE OF THE ROAD. FOUND NO OTHER OBJECTS. ACCEPTED THE 3/8" REROD AS THE BEST AVAILABLE EVIDENCE OF THE POSITION OF THE ORIGINAL CORNER.


C. Description of monument for corner and accessories established to perpetuate locating the position of the corner:

L-13 REPLACED FOUND 3/8" REROD WITH 5/8" X 24" REROD WITH BAY COUNTY REMONUMENTATION CAP WITH 3/16" DRILL HOLE IN MONUMENT BOX.  
 WEST 7.92' TO BAY COUNTY REMONUMENTATION CORNER, N 1/4 CORNER SECTION 1, T16N, R3E  
 N 30°E 13.56' SET CAPPED 3/8" REROD  
 S 35°E 5.71' SET CAPPED 3/8" REROD  
 S 80°W 21.05' SET CAPPED 3/8" REROD  
 N 55°W 23.93' SET CAPPED 3.8" REROD  
 N 35°W 54.14' SET NAIL/TAG WEST FACE OF UTILITY POLE  
 S 5°W 71.98' SET NAIL/TAG EAST FACE UTILITY POLE

Signed by Paul M. Ciosok

Date 12/23/97

Surveyor's Michigan License No. 25835

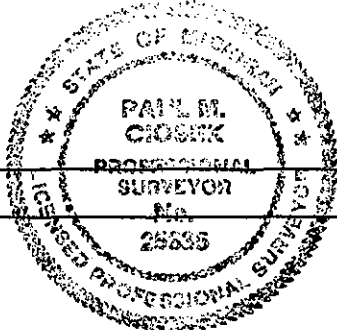

FIELDBOOK# \_\_\_\_\_, PAGE 30

APPROVED LAND CORNER  
 P.A. 345 OF 1990 - Bay County  
 Date 23 Oct 97  
MJM  
 Michael MacDonald P.S.  
 County Representative

FORM APPROVED BY MICHIGAN STATE BOARD OF PROFESSIONAL SURVEYORS, JAN. 28, 1971

REVISED MAY 14, 1976  
 REVISED JAN., 198  
 REVISED OCT., 198

004 - 67