

MAR 17 1999

SECTION

BAY COUNTY REMONUMENTATION LAND CORNER RECORDATION CERTIFICATE Filing Requirement of Act 74, Mich. P.A. 1970

For corners in

Form with fields for BAY COUNTY, Located in: T 18N R 3E, Corner Code # K-5, and categories 1-5 for Public Land Survey, Property Controlling, and Miscellaneous Property.

Vertical stamp: REGISTER OF DEEDS BAY COUNTY, MICHIGAN

Vertical stamp: 1999 JAN -5 A 9:07

Vertical stamp: RECORDED

Register of Deeds Stamp & File Number

4. Lot No. , Recorded Plat
5. Private Claims


I, DALE L. WINIECKE, in a field survey on JULY 10, 1998 do hereby state that under requirements of P.A. 74, Michigan P.A. of 1970; the corner points mentioned in lines 1 and 2 above were in conformance with regulations and rules therefore as required in the current manual of survey instructions of the United States Department of the Interior, Bureau of Land Management or by a decree of a Court of Law and /or that the corner points mentioned in lines 3, 4 and 5 above were in conformance with the rules of the Michigan Board of Land Surveyors or by a Decree of a Court of Law; established, re-established, monumented, recovered, found as expressed below:

NOTE: Not more than 2 corners, all in the same Town and Range, may be recorded on this certificate.

Grid table with columns A-L and rows 1-13. A dot is marked at the intersection of column K and row 5.

A. Description of original monument and accessories and/or subsequent restoration:

K-5
POST SET BY J. MULLETT D.S. IN 1846
12" HEMLOCK N28°W 79 LINKS
36" WHITE PINE S55°E 34 LINKS
CORNER ESTABLISHED WHEN HIGHWAY WAS LAID OUT PER COUNTY SURVEYOR NOTES, G. TURNER, 1904. FOUND OLD CORNER BY FORMER COUNTY SURVEYOR, G. TURNER, 1908. SURVEY, UNRECORDED, EDMANDS (1970), FOUND CORNER LCRC, L. 2, P 198, J. SEDGMAN, PS#18664 (1975), FOUND 1/2" BAR FIELD NOTES, LAPHAM AND ASSOC., INC., GLADWIN OFFICE (1985), FOUND 1/2" REROD FIELD NOTES, LAPHAM AND ASSOC., INC., NO DATE, FOUND 1/2" IRON

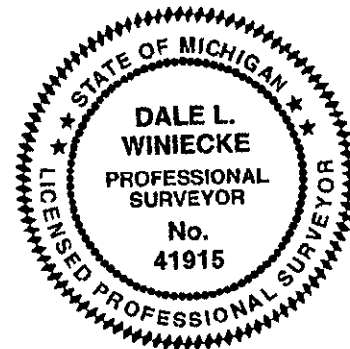

B. Description of corner evidence found and/or method applied in restoring or reestablishing corner:

K-5
SEARCHED THE APPARENT LOCATION OF THE CORNER AND FOUND A 1/2" CAPPED REROD PS#27458 M. ROBISON. EXCAVATED THE AREA UNDER THE 1/2" CAPPED REROD AND FOUND A LARGE ROCK AT 36" BELOW ROAD SURFACE AND STOPPED EXCAVATION. FOUND NO OTHER OBJECTS IN THE AREA. CHECKED WITNESSES FROM LCRC L.2, P.198 S45°E 107.80' (R) 107.69' (M) TO N&T IN P. POLE; N45°E 35.50'(R) 35.42' 9M) TO ROAD SIGN POST; N45°W 32.90'(R) 32.80' (M) TO TOP CENTERLINE OF NORTH END CONCRETE CULVERT; S45°W 34.90'(R) 34.64' (M) TO TOP CENTERLINE OF SOUTH END CONCRETE CULVERT; THE 1/2" CAPPED REROD PS#27458 WAS ACCEPTED AS THE BEST AVAILABLE EVIDENCE OF THE POSITION OF THE ORIGINAL CORNER.

C. Description of monument for corner and accessories established to perpetuate locating the position of the corner:

K-5
REPLACED 1/2" CAPPED REROD PS#27548 WITH 5/8" X 24" LONG REROD WITH BAY COUNTY REMONUMENTATION CAP IN MONUMENT BOX. N34°W 87.48' TO SET NAIL & TAG IN NORHT FACE OF RAILROAD TIE S80°W 158.60' TO SET NAIL & TAG IN NORTH FACE OF U. POLE S54°E 107.69' TO FOUND NAIL & TAG IN NORTH FACE OF U. POLE N56°E 35.42' TO FACE OF ROAD SIGN POST

APPROVED LAND CORNER
P.A. 345 OF 1990 - Bay County
Date 27 Aug 98
MJN
Michael MacDonald P.S.
County Represent Date 12/30/98

Signed by Dale Winiecke

Surveyor's Michigan License No. 41915