

1999 JAN 5 1999

SECTION

BAY COUNTY REMONUMENTATION LAND CORNER RECORDATION CERTIFICATE Filing Requirement of Act 74, Mich. P.A. 1970

For corners in

Form with fields for BAY COUNTY (County), Located In: T 18N R 3E, Corner Code # K-11, and numbered sections 1-5 for Public Land Survey, Property Controlling, and Miscellaneous Property.

REGISTER OF DEEDS BAY COUNTY, MICHIGAN stamp with date 1999 JAN -5 A 9:07 and RECORDER name. Includes Register of Deeds Stamp & File Number.

4. Lot No. , Recorded Plat
5. Private Claims

I, DALE L. WINECKE, in a field survey on NOVEMBER 9, 1998 do hereby state that under requirements of P.A. 74, Michigan P.A. of 1970, the corner points mentioned in lines 1 and 2 above were in conformance with regulations and rules therefore as required in the current manual of survey instructions of the United States Department of the Interior, Bureau of Land Management or by a decree of a Court of Law and /or that the corner points mentioned in lines 3, 4 and 5 above were in conformance with the rules of the Michigan Board of Land Surveyors or by a Decree of a Court of Law; established, re-established, monumented, recovered, found as expressed below:

NOTE: Not more than 2 corners, all in the same Town and Range, may be recorded on this certificate.

Grid table with columns A-L and rows 1-13. A dot is marked at the intersection of column K and row 11.

A. Description of original monument and accessories and/or subsequent restoration:

K-11
POST SET BY, J. MULLETT, D.S. MAY 1846
18" ELM, N 58°E 35 LINKS
12" WHITE ASH, S 61°W 33 LINKS

COUNTY SURVEYOR NOTES-SECTION 36, T18N, R3E-G. TURNER-1910 ±, FOUND OLD CORNER SET BY FORMER COUNTY SURVEYOR CERTIFICATE OF SURVEY, L. 1135, P. 213, D. BURGIN, PS# 29240 (1989), FOUND NAIL AND TAG


B. Description of corner evidence found and/or method applied in restoring or reestablishing corner:

K-11
SEARCHED THE APPARENT LOCATION OF THE CORNER AND FOUND A NAIL AND TAG USED IN THE CERTIFICATE OF SURVEY RECORDED IN LIBER 1135, PAGE 213. EXCAVATED THE AREA UNDER THE NAIL AND TAG AND FOUND NO OTHER OBJECTS IN THE AREA. THE NAIL AND TAG WAS ACCEPTED AS THE BEST AVAILABLE EVIDENCE OF THE POSITION OF THE ORIGINAL CORNER.

C. Description of monument for corner and accessories established to perpetuate locating the position of the corner:

K-11
REPLACED NAIL AND TAG WITH 5/8" x 24" LONG REROD WITH BAY COUNTY REMONUMENTATION CAP IN MONUMENT BOX.
N 30°E 59.40' TO CENTERLINE OF TELEPHONE RISER
S 40°E 68.40' TO FOUND PK NAIL IN NE FACE OF POWER POLE
N 40°W 124.00' TO SOUTHEAST CORNER OF MOBLE HOME
S 45°W 48.9' TO SOUTHEAST CORNER OF WOOD POST

APPROVED LAND CORNER
P.A. 345 OF 1930 - Bay County
Date 12 Nov 98
MJM
Michael MacDonald P.S.
County Representative

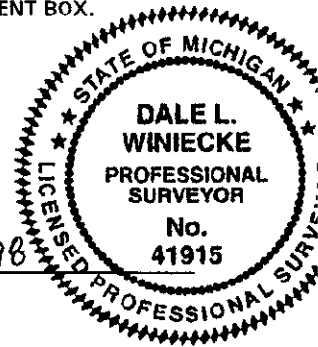

Signed by Dale Winecke
Surveyor's Michigan License No. 41915

Date 12/30/98