

JAN 17 1999

SECTION

BAY COUNTY REMONUMENTATION LAND CORNER RECORDATION CERTIFICATE Filing Requirement of Act 74, Mich. P.A. 1970

For corners in

Form with fields for BAY COUNTY (County), Located In, Corner Code #, and numbered sections 1-5 for Public Land Survey, Property Controlling in Section, Miscellaneous Property in Sec., Lot No., and Private Claims.

Vertical stamp: REGISTER OF DEEDS BAY COUNTY, MICHIGAN

Vertical stamp: 1999 JAN - 5 A 9:09

Vertical stamp: RECORDED

Register of Deeds Stamp & File Number

I, DALE L. WINECKE, in a field survey on JUNE 30, 1998 do hereby state that under requirements of P.A. 74, Michigan P.A. of 1970, the corner points mentioned in lines 1 and 2 above were in conformance with regulations and rules therefore as required in the current manual of survey instructions of the United States Department of the Interior, Bureau of Land Management or by a decree of a Court of Law and/or that the corner points mentioned in lines 3, 4 and 5 above were in conformance with the rules of the Michigan Board of Land Surveyors or by a Decree of a Court of Law; established, re-established, monumented, recovered, found as expressed below:

NOTE: Not more than 2 corners, all in the same Town and Range, may be recorded on this certificate.

Grid table with columns A-L and rows 1-13, containing numbers 1-36.

A. Description of original monument and accessories and/or subsequent restoration:

M-11 POST SET BY L CLASON IN 1837 ELM 24" S83°W 20L ELM 15" N 63°W 15L

BAY COUNTY SURVEYOR NOTES - SECTION 36, T18N, R3E, FOUND OLD CORNER SET BY FORMER COUNTY SURVEYOR - G. TURNER - 1910. BAY COUNTY SURVEYOR NOTES - SECTION 25, T18N, R3E - FOUND OLD CORNER SET BY FORMER COUNTY SURVEYOR - G. TURNER - 1910 ± ARENAC COUNTY SURVEYOR NOTES - SECTION 31, T18N, R4E, FOUND POST - 1916 LINCOLN DRAIN MINUTES OF SURVEY 1994 ARENAC COUNTY REMONUMENTATION LCRC L. 002, P. 38


B. Description of corner evidence found and/or method applied in restoring or reestablishing corner:

M-11 FOUND 5/8" REBAR WITH ARENAC COUNTY REMONUMENTATION CAP IN MONUMENT BOX IN 1994 STANDARD SECTION CORNER COMMON TO SECTION 25 AND 36, T18N, R3E, AND SECTION 30 AND 31, T18N, R4E SET BY SINGLE PROPORTIONAL MEASUREMENT USING BAY COUNTY SURVEYOR NOTES IN SECTION 25 AND 36 BETWEEN M-12 T18N, R3E (A-11 T18N, R4E) AND M-9 T18N, R3E (A-9T18N, R4E) ON LINE. MONUMENT FALLS ON THE NORTH EDGE OF WORTH ROAD (EAST-WEST ROAD) AND THE SOUTH BANK OF THE LINCOLN DRAIN IN AGREEMENT WITH DRAIN MINUTES OF SURVEY. MONUMENT FALLS IN HARD SURFACE ROAD JUST SOUTH OF BRIDGE OVER DRAIN ON LINE OF NORTH-SOUTH ROAD. OLD CORNER WAS LIKELY OBLITERATED DURING BRIDGE AND DRAIN CONSTRUCTION AND NO EXCAVATION WAS PERFORMED EXCEPT UNDER SET MONUMENT POSITION. MONUMENT ACCEPTED AS THE BEST AVAILABLE EVIDENCE OF THE POSITION OF THE ORIGINAL CORNER CORNER APPROVED BY ARENAC COUNTY REMONUMENTATION PEER REVIEW GROUP IN 1994.

C. Description of monument for corner and accessories established to perpetuate locating the position of the corner:

M-11 FOUND 5/8" REBAR WITH BAY-ARENAC COUNTY REMONUMENTATION CAP IN MONUMENT BOX S39°W 81.31' TO NAIL AND TAG IN SOUTHEAST SIDE U POLE N12°W 65.91' TO NAIL AND TAG IN WEST SIDE TRIPLE 24" POPLAR S38°W 29.39' TO 3/8" REBAR WITH CAP #39088 S31°E 150.26' TO NORTHWEST CORNER BLOCK FOUNDATION OF HOUSE S 11.2' TO PHYSICAL CENTERLINE WORTH ROAD N20°W 85.04' TO NAIL AND TAG IN EAST FACE OF 15" ELM

APPROVED LAND CORNER P.A. 345 OF 1990 - Bay County Date 6 Aug 98 M.L.M. Michael MacDonald P.S. County Representative

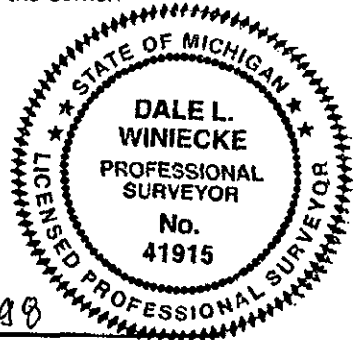

Signed by Dale Winecke

Date 12/30/98

Surveyor's Michigan License No. 41915